

STANDARD NOTES

THE OWNER(S), DEVELOPER(S) AND/OR SUBDIVIDER(S) OF THE RICHMIL OPEN SPACE PARKING LOT EXPANSION PLAN SET, THEIR RESPECTIVE SUCCESSORS, HEIRS AND/OR ASSIGNS AGREE TO THE FOLLOWING NOTES:

1. THE COUNTY ENGINEER STAMP AND SIGNATURE AFFIXED TO THIS DOCUMENT INDICATES THE DEPARTMENT OF PUBLIC WORKS AND DEVELOPMENT HAS REVIEWED THE DOCUMENT AND FOUND IT IN GENERAL CONFORMANCE WITH THE ARAPAHOE COUNTY SUBDIVISION REGULATIONS OR APPROVED VARIANCES TO THOSE REGULATIONS. THE COUNTY ENGINEER, THROUGH APPROVAL OF THIS DOCUMENT, ASSUMES NO RESPONSIBILITY, OTHER THAN STATED ABOVE, FOR THE COMPLETENESS AND/OR ACCURACY OF THESE DOCUMENTS. THE OWNER AND ENGINEER UNDERSTAND THAT IT IS THE POLICY AND PRACTICE OF ARAPAHOE COUNTY NOT TO ACCEPT LIABILITY FOR FACILITIES DESIGNED BY OTHERS. THE RESPONSIBILITY FOR THE ENGINEERING ADEQUACY OF THE FACILITIES DEPICTED IN THIS DOCUMENT LIES SOLELY WITH THE REGISTERED PROFESSIONAL ENGINEER WHOSE STAMP AND SIGNATURE ARE AFFIXED TO THIS DOCUMENT.
2. ALL ROADWAY CONSTRUCTION SHALL CONFORM TO THE ARAPAHOE COUNTY INFRASTRUCTURE DESIGN AND CONSTRUCTION STANDARDS.
3. ALL MATERIALS AND WORKMANSHIP SHALL BE SUBJECT TO INSPECTION BY THE ARAPAHOE COUNTY DEPARTMENT OF PUBLIC WORKS AND DEVELOPMENT AND ARAPAHOE COUNTY OPEN SPACES. THE COUNTY RESERVES THE RIGHT TO ACCEPT OR REJECT ANY SUCH MATERIALS AND WORKMANSHIP THAT DOES NOT CONFORM TO ITS STANDARDS AND SPECIFICATIONS.
4. THE CONTRACTOR SHALL NOTIFY THE ARAPAHOE COUNTY DEPARTMENT OF PUBLIC WORKS, ARAPAHOE COUNTY OPEN SPACES, AND DEVELOPMENT INSPECTION SECTION AT 720-874-6500, A MINIMUM OF 48 HOURS AND A MAXIMUM OF 96 HOURS PRIOR TO STARTING CONSTRUCTION.
5. THE CONTRACTOR SHALL VERIFY THE LOCATION OF EXISTING UTILITIES PRIOR TO ACTUAL CONSTRUCTION. FOR INFORMATION CONTACT THE DENVER INTER-UTILITY GROUP AT 303-534-6700, OR AT 1-800-922-1987
6. THE CONTRACTOR SHALL HAVE ONE (1) SIGNED COPY OF THE PLANS (APPROVED BY THE DEPARTMENT OF PUBLIC WORKS AND DEVELOPMENT) AND ONE (1) COPY OF THE INFRASTRUCTURE DESIGN AND CONSTRUCTION STANDARDS AT THE JOB SITE AT ALL TIMES.
7. A PLAN FOR TRAFFIC CONTROL DURING CONSTRUCTION SHALL BE SUBMITTED TO ARAPAHOE COUNTY FOR APPROVAL WITH THE PERMIT APPLICATION. A STREET CUT AND RIGHT OF WAY USE PERMIT OR PUBLIC IMPROVEMENT CONSTRUCTION PERMIT WILL NOT BE ISSUED WITHOUT AN APPROVED TRAFFIC CONTROL PLAN FOR TRAFFIC CONTROL DURING CONSTRUCTION.
8. THESE CONSTRUCTION PLANS SHALL BE CONSIDERED VALID FOR A PERIOD OF TWO (2) YEARS FROM THE DATE OF COUNTY ACCEPTANCE, AFTER WHICH TIME THESE PLANS SHALL BE VOID AND WILL BE SUBJECT TO ADDITIONAL REVIEW AND ACCEPTANCE BY ARAPAHOE COUNTY.
9. CONTRACTOR SHALL NOTIFY THE ARAPAHOE COUNTY ENGINEERING INSPECTION SECTION WHEN WORKING OUTSIDE OF THE PUBLIC RIGHT-OF-WAY ON A FACILITY, WHICH WILL BE CONVEYED TO THE COUNTY, URBAN DRAINAGE AND FLOOD CONTROL DISTRICT, OR OTHER SPECIAL DISTRICT FOR MAINTENANCE (STORM SEWER, ENERGY DISSIPATORS, DETENTION POND OUTLET STRUCTURES, OR OTHER DRAINAGE INFRASTRUCTURE). FAILURE TO NOTIFY THE ENGINEERING INSPECTION SECTION TO ALLOW FOR INSPECTION OF THIS CONSTRUCTION MAY RESULT IN NON-ACCEPTANCE OF THE FACILITIES BY THE COUNTY.

DRAINAGE MAINTENANCE

1. THE PROPERTY OWNER SHALL BE RESPONSIBLE FOR MAINTENANCE OF ALL DRAINAGE FACILITIES INSTALLED PURSUANT TO THE SUBDIVISION AGREEMENT. REQUIREMENTS INCLUDE, BUT ARE NOT LIMITED TO MAINTAINING THE SPECIFIED STORM WATER DETENTION/ RETENTION VOLUMES, MAINTAINING OUTLET STRUCTURES, FLOW RESTRICTION DEVICES AND FACILITIES NEEDED TO CONVEY FLOW TO SAID BASINS. ARAPAHOE COUNTY SHALL HAVE THE RIGHT TO ENTER PROPERTIES TO INSPECT SAID FACILITIES AT ANY TIME. IF THESE FACILITIES ARE NOT PROPERLY MAINTAINED, THE COUNTY MAY PROVIDE NECESSARY MAINTENANCE AND ASSESS THE MAINTENANCE COST TO THE OWNER OF THE PROPERTY.

EMERGENCY ACCESS NOTE

1. EMERGENCY ACCESS IS GRANTED HEREWITH OVER AND ACROSS ALL PAVED AREAS FOR POLICE, FIRE AND EMERGENCY VEHICLES.


DRIVES, PARKING AREAS, AND UTILITY EASEMENT MAINTENANCE

1. THE OWNERS OF THIS PLAN OR PLAT, THEIR SUCCESSORS, AND/OR ASSIGNS IN INTEREST, THE ADJACENT PROPERTY OWNER(S), HOMEOWNERS ASSOCIATION OR OTHER ENTITY OTHER THAN ARAPAHOE COUNTY, IS RESPONSIBLE FOR MAINTENANCE AND UPKEEP OF ANY AND ALL DRIVES, PARKING AREAS, AND EASEMENTS, I.E.: CROSS-ACCESS EASEMENTS, DRAINAGE EASEMENTS, ETC.

DRAINAGE LIABILITY

1. IT IS THE POLICY OF ARAPAHOE COUNTY THAT IT DOES NOT AND WILL NOT ASSUME LIABILITY FOR THE DRAINAGE FACILITIES DESIGNED AND/OR CERTIFIED BY BOHANNAN HUSTON. ARAPAHOE COUNTY REVIEWS DRAINAGE PLANS PURSUANT TO COLORADO REVISED STATUTES TITLE 30, ARTICLE 28, BUT CANNOT, ON BEHALF OF ARAPAHOE COUNTY GUARANTEE THAT FINAL DRAINAGE DESIGN REVIEW WILL ABSOLVE ARAPAHOE COUNTY AND/OR THEIR SUCCESSORS AND/OR ASSIGNS OF FUTURE LIABILITY FOR IMPROPER DESIGN. IT IS THE POLICY OF ARAPAHOE COUNTY THAT APPROVAL OF THE FINAL PLAT AND/OR FINAL DEVELOPMENT PLAN DOES NOT IMPLY APPROVAL OF BOHANNAN HUSTON DRAINAGE DESIGN.

PORTIONS OF THE SOUTH $\frac{1}{2}$ OF SECTION 2, TOWNSHIP 5 SOUTH, RANGE 60 WEST OF THE 6TH P.M.,
AND A PORTION OF THE EAST $\frac{1}{2}$ OF SECTION 11, TOWNSHIP 5 SOUTH, RANGE 60 WEST OF THE 6TH P.M.
COUNTY OF ARAPAHOE, STATE OF COLORADO

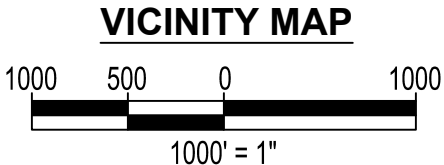


<u>INDEX OF SHEETS</u>		
<u>SHEET NO.</u>	<u>SUBSET SHEETS</u>	<u>DESCRIPTION</u>
01	TTL-01	TITLE SHEET
02	PLN-01	SITE PLANS
03	GRD-01 TO GRD -02	GRADING PLANS
05	UTL-01 TO UTL-02	UTILITY PLANS
07	STR-01	STRIPING AND CIRCULATION PLANS
08	DET-01 TO DET-04	DETAILS

BENCHMARK:
ARAPAHOE COUNTY MAPPING BENCHMARK P5-25 2004 LS 22568 BASIS OF ELEVATION
BHI POINT #704 N: 1658889.537 E: 3405351200 ELEVATION 5154.699 CAP DIA=3.2250"

THE ELEVATIONS REPORTED HEREON ARE REFERENCED TO THE NORTH AMERICAN VERTICAL DATUM OF 1988 (NAVD88), FIELD AND OFFICE PROCEDURES FOLLOWED FGCC 1ST ORDER CLASS II SPECIFICATIONS, THE EXISTING VERTICAL CONSTRAINTS ARE SECOND ORDER CLASS 0, THEREFORE THIS SURVEY IS CLASSIFIED AS A SECOND ORDER CLASS 0 SURVEY AS DEFINED BY NGS.

ALL GEODETIC POSITIONS LISTED HEREON ARE BASED UPON AUTONOMOUS GLOBAL POSITIONING SYSTEM (GPS) MEASUREMENTS AND HAVE A POSITIONAL TOLERANCE OF 30 FEET +. POSITIONS ARE RELATIVE TO THE NORTH AMERICAN DATUM OF 1983.

FILE NAME: 20240239.GEN.TITLE.DWG		<div><div><div></div></div><div>ARAPAHOE COUNTY</div></div>			AS CONSTRUCTED	CONTRACT INFORMATION		PROJECT NO./CODE			
PLOT DATE: 2024/05/09, 12:59 PLOT STYLE: BHNC.S.TB					<div><div>R-X</div><div></div><div></div><div></div><div></div></div>	DATE	DESIGNER:	INITIALS	NO REVISIONS:	CONTRACTOR:	
<div><div><div>Bohannon</div><div>Huston</div></div><div><div>www.bhinc.com</div><div>800.877.5332</div><div>9785 Maroon Circle Suite 140 Englewood , CO 80112-5928</div></div></div>									PROJECT MANAGER: ATC		
									PROJECT ENGINEER: DCP		
									PROJECT STARTED: 10/05/23	ACCEPTED:	SHEET NUMBER01
									COMMENTS:		

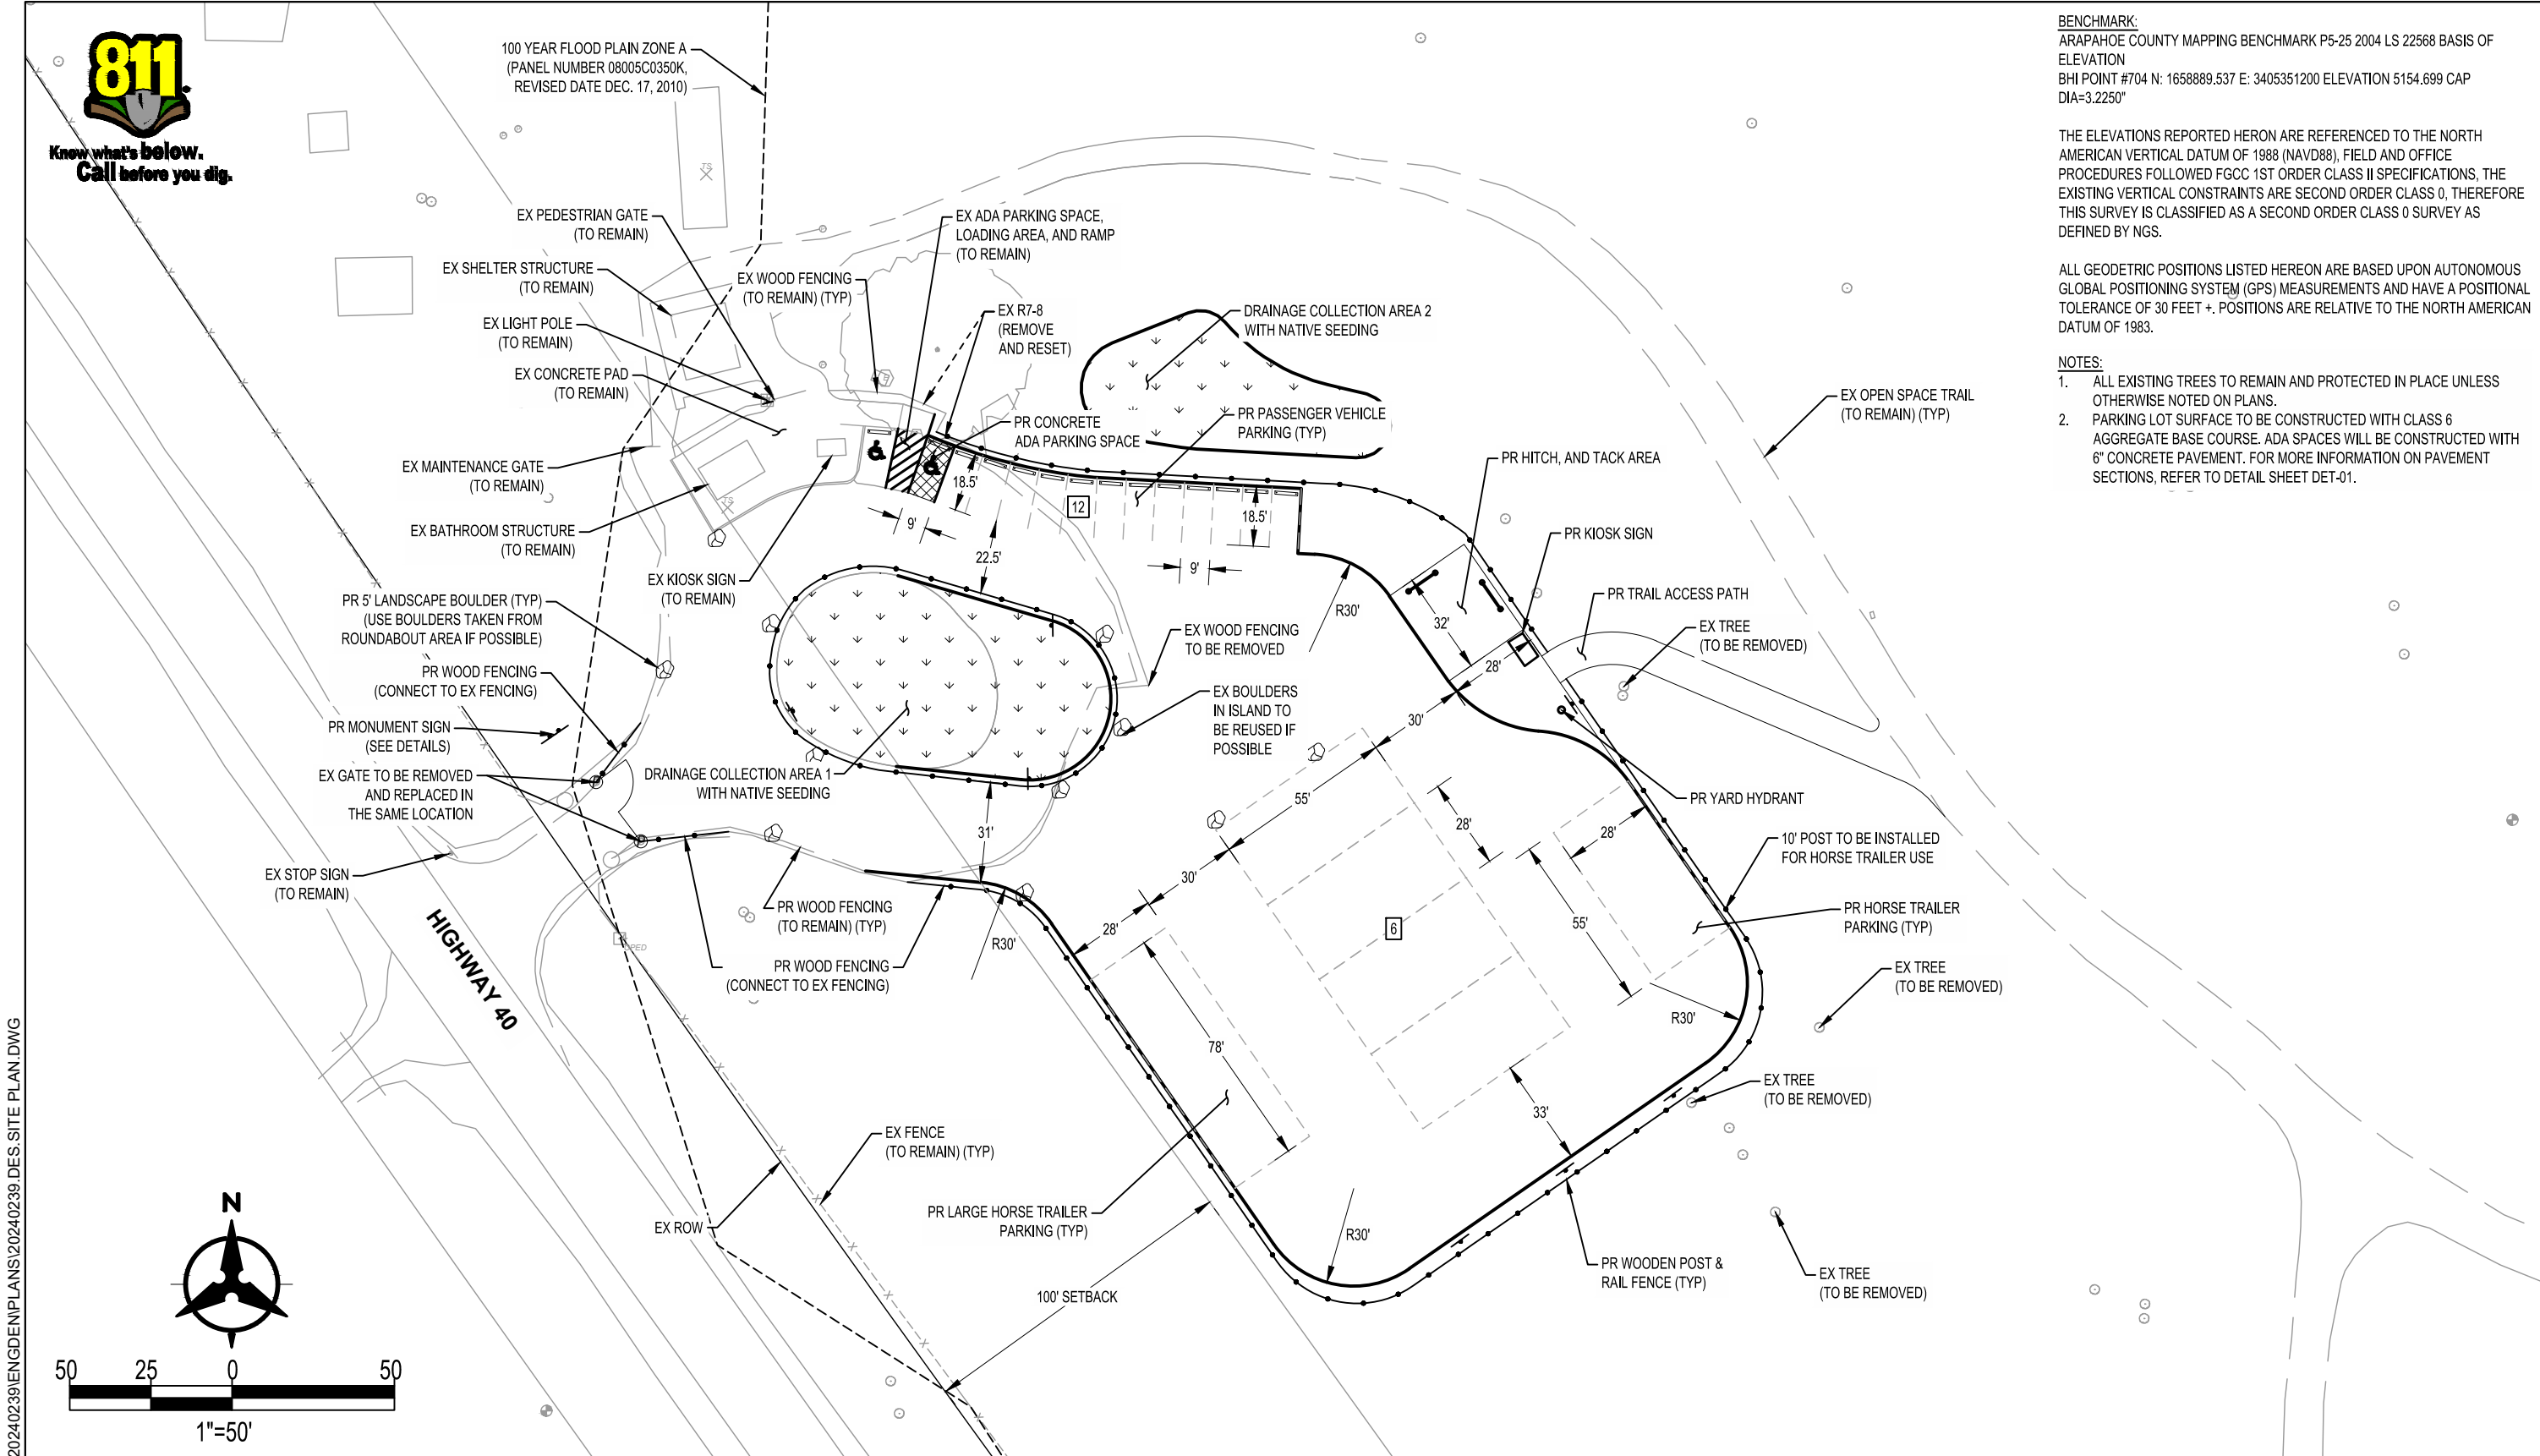

BENCHMARK:
ARAPAHOE COUNTY MAPPING BENCHMARK P5-25 2004 LS 22568 BASIS OF ELEVATION
BHI POINT #704 N: 1658889.537 E: 3405351200 ELEVATION 5154.699 CAP DIA=3.2250"

THE ELEVATIONS REPORTED HERON ARE REFERENCED TO THE NORTH AMERICAN VERTICAL DATUM OF 1988 (NAVD88), FIELD AND OFFICE PROCEDURES FOLLOWED FGCC 1ST ORDER CLASS II SPECIFICATIONS, THE EXISTING VERTICAL CONSTRAINTS ARE SECOND ORDER CLASS 0, THEREFORE THIS SURVEY IS CLASSIFIED AS A SECOND ORDER CLASS 0 SURVEY AS DEFINED BY NGS.

ALL GEODETRIC POSITIONS LISTED HEREON ARE BASED UPON AUTONOMOUS GLOBAL POSITIONING SYSTEM (GPS) MEASUREMENTS AND HAVE A POSITIONAL TOLERANCE OF 30 FEET +. POSITIONS ARE RELATIVE TO THE NORTH AMERICAN DATUM OF 1983.

- NOTES:**
1. ALL EXISTING TREES TO REMAIN AND PROTECTED IN PLACE UNLESS OTHERWISE NOTED ON PLANS.
 2. PARKING LOT SURFACE TO BE CONSTRUCTED WITH CLASS 6 AGGREGATE BASE COURSE. ADA SPACES WILL BE CONSTRUCTED WITH 6" CONCRETE PAVEMENT. FOR MORE INFORMATION ON PAVEMENT SECTIONS, REFER TO DETAIL SHEET DET-01.

\\A-CO-FS\PROJECTS\20240239\ENGIN\PLANS\20240239.DES SITE PLAN.DWG

PLOTTED BY: JESSICA MCELWAIN, 5/9/2024 12:59 PM
HORIZ. SCALE: VERT. SCALE:


Bohannon & Huston
www.bhinc.com 800.877.5332
9785 Maroon Circle Suite 140 Englewood, CO 80112-5928

SHEET REVISIONS			
DATE	DESIGNER:	INITIALS	

 **ARAPAHOE COUNTY**

AS CONSTRUCTED		ARAPAHOE COUNTY RICHMIL RANCH OPEN SPACE SITE PLAN			PROJECT NO./CODE
NO REVISIONS:					
REVISED:		DESIGNER: ATC	STR. NO'S.	N/A	
VOID:		DETAILER: DCP		N/A	
		SUBSET: GENERAL	SHEETS: PLN-01	OF 01	SHEET NUMBER 02

MAY 2024 - FINAL PLANS - NOT FOR CONSTRUCTION

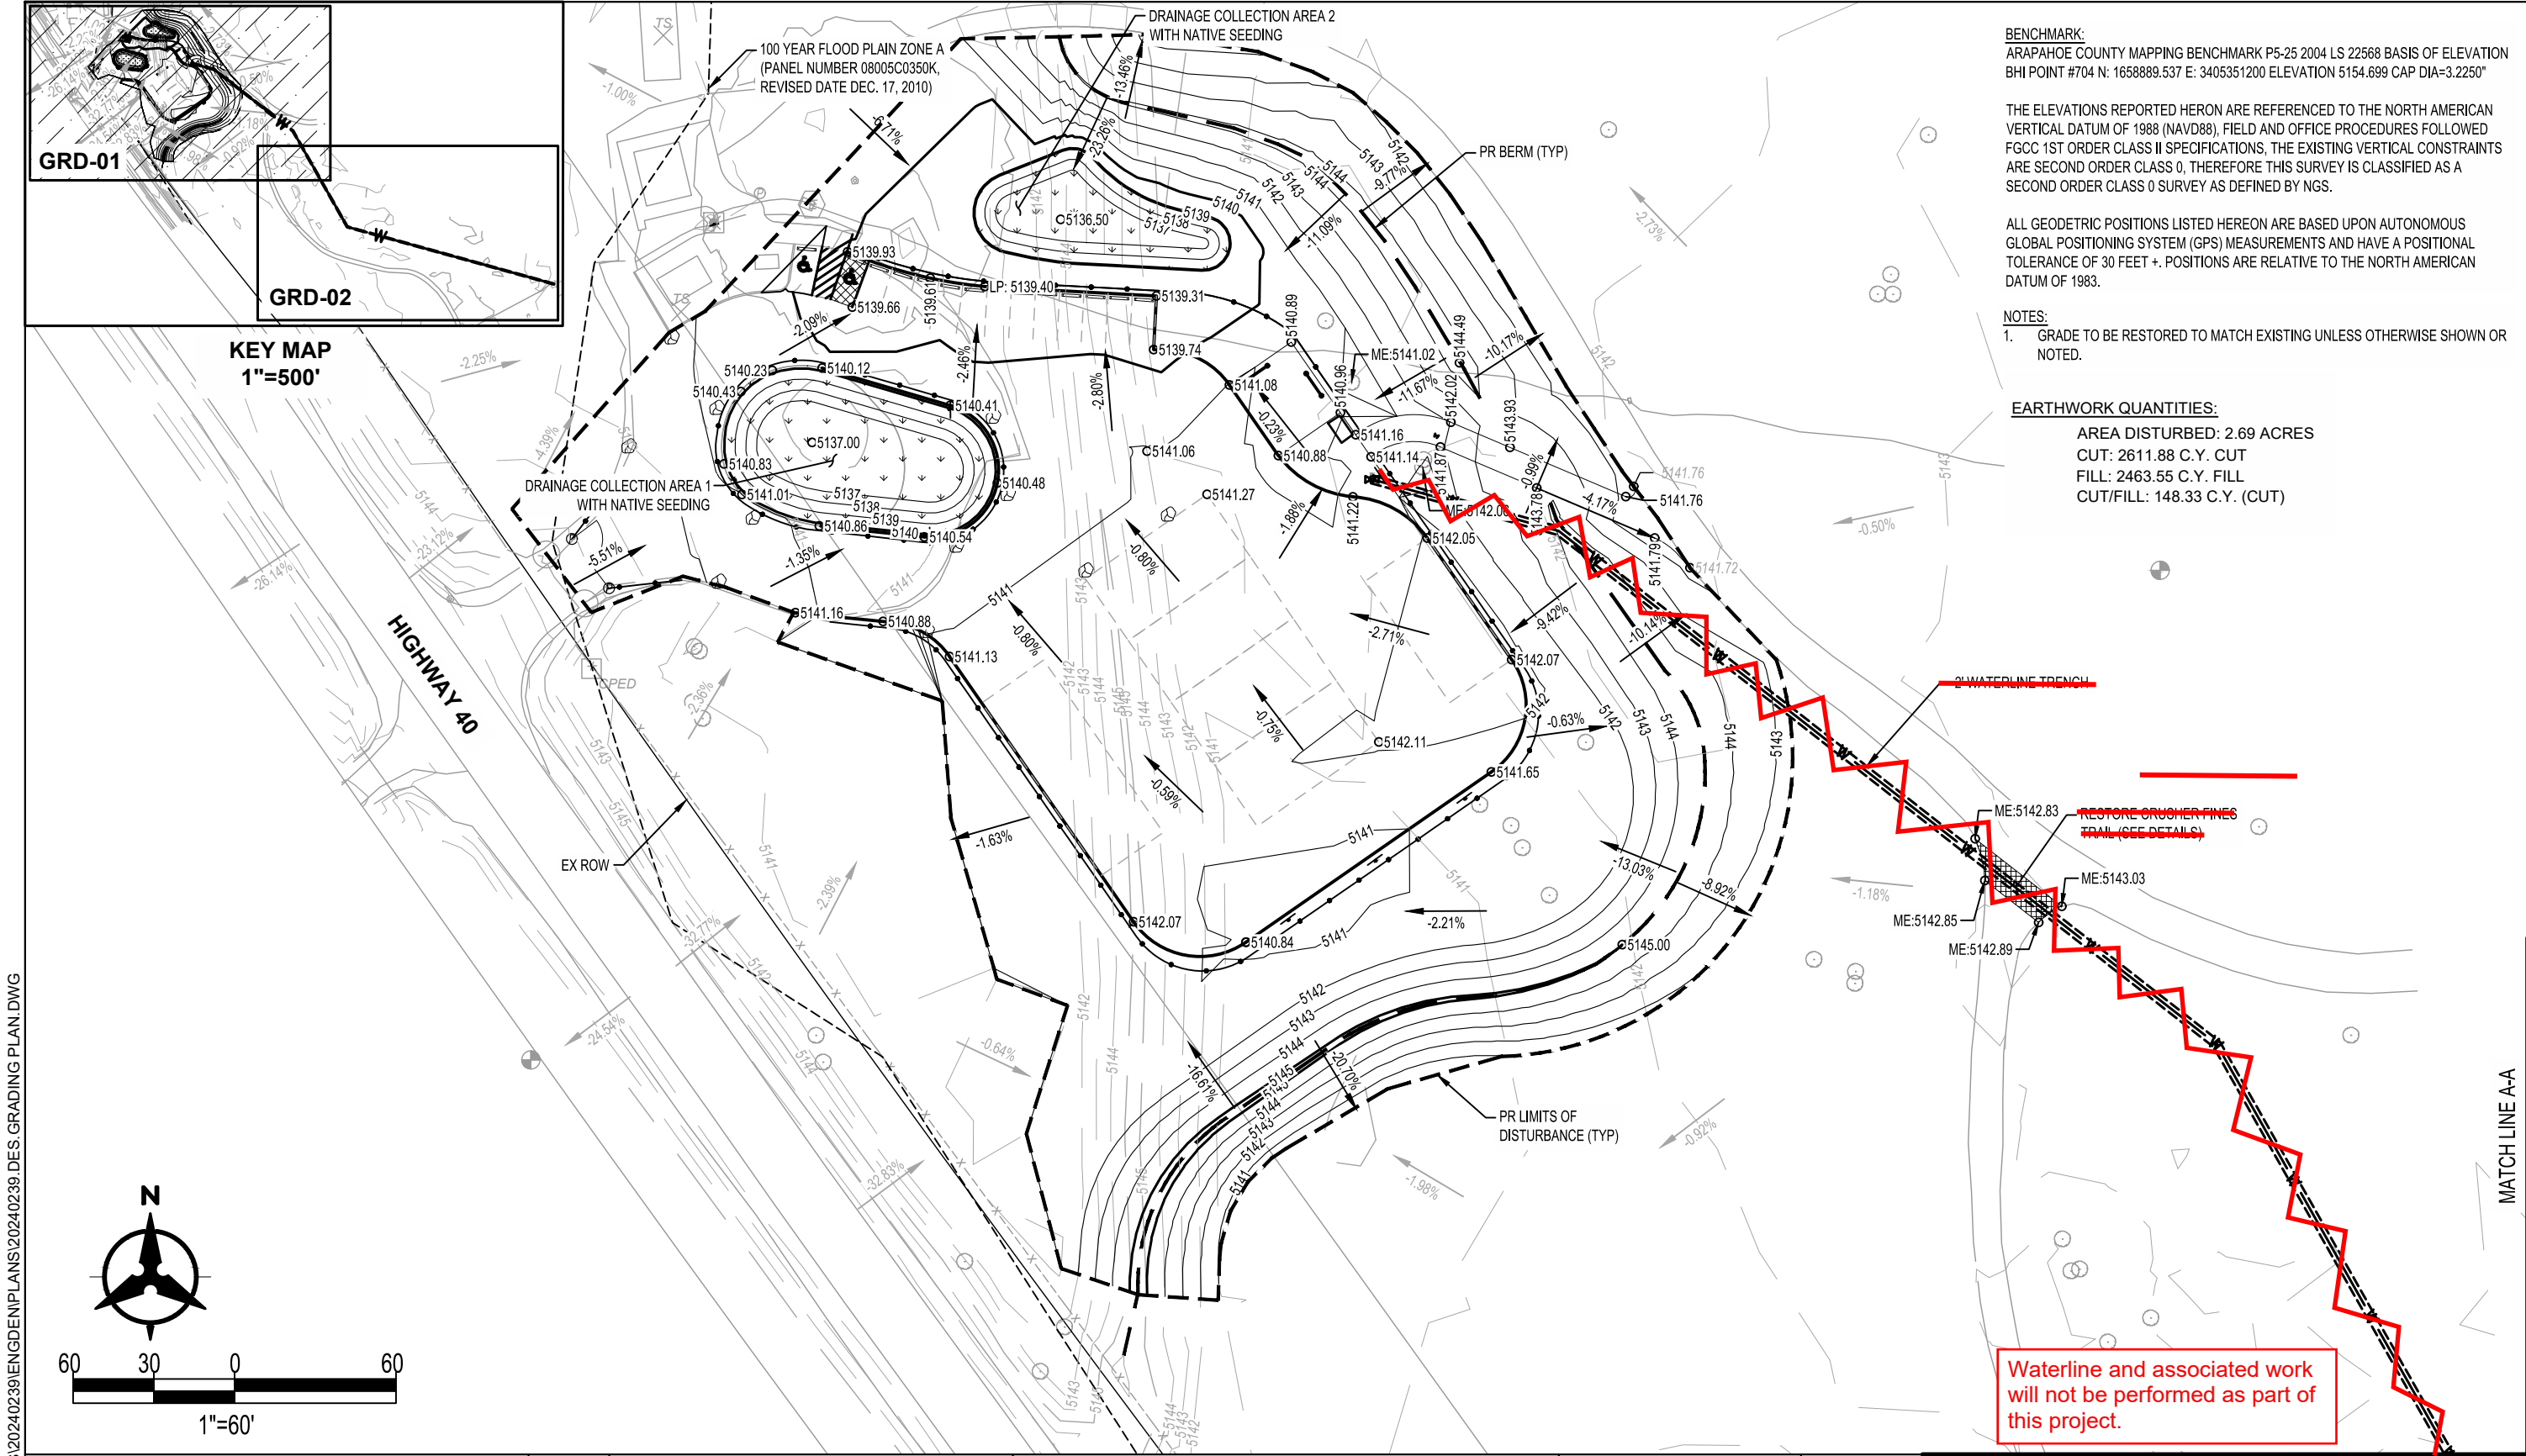

BENCHMARK:
ARAPAHOE COUNTY MAPPING BENCHMARK P5-25 2004 LS 22568 BASIS OF ELEVATION
BHI POINT #704 N: 1658889.537 E: 3405351200 ELEVATION 5154.699 CAP DIA=3.2250"

THE ELEVATIONS REPORTED HEREON ARE REFERENCED TO THE NORTH AMERICAN
VERTICAL DATUM OF 1988 (NAVD88). FIELD AND OFFICE PROCEDURES FOLLOWED
FGCC 1ST ORDER CLASS II SPECIFICATIONS, THE EXISTING VERTICAL CONSTRAINTS
ARE SECOND ORDER CLASS 0, THEREFORE THIS SURVEY IS CLASSIFIED AS A
SECOND ORDER CLASS 0 SURVEY AS DEFINED BY NGS.


ALL GEODETRIC POSITIONS LISTED HEREON ARE BASED UPON AUTONOMOUS
GLOBAL POSITIONING SYSTEM (GPS) MEASUREMENTS AND HAVE A POSITIONAL
TOLERANCE OF 30 FEET +. POSITIONS ARE RELATIVE TO THE NORTH AMERICAN
DATUM OF 1983.

NOTES:
1. GRADE TO BE RESTORED TO MATCH EXISTING UNLESS OTHERWISE SHOWN OR
NOTED.

EARTHWORK QUANTITIES:
AREA DISTURBED: 2.69 ACRES
CUT: 2611.88 C.Y. CUT
FILL: 2463.55 C.Y. FILL
CUT/FILL: 148.33 C.Y. (CUT)

Waterline and associated work
will not be performed as part of
this project.

IA-CO-FSI-PROJECTS\20240239\ENGIN\PLANS\20240239.DES GRADING PLAN.DWG

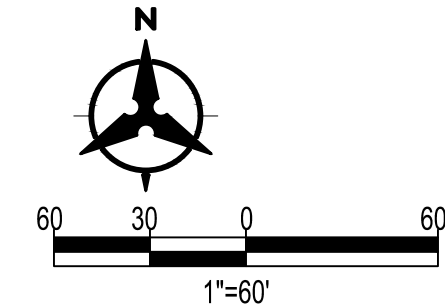

PLOTTED BY: JESSICA MCELWAIN, 5/9/2024 12:59 PM
HORIZ. SCALE: VERT. SCALE:

Bohannon & Huston
www.bhinc.com 800.877.5332
9785 Maroon Circle Suite 140 Englewood, CO 80112-5928


SHEET REVISIONS			
R-X	DATE	DESIGNER:	INITIALS



AS CONSTRUCTED		ARAPAHOE COUNTY RICHMIL RANCH OPEN SPACE GRADING PLAN			PROJECT NO./CODE
NO REVISIONS:		DESIGNER: ATC			
REVISED:		DETAILER: DCP			
VOID:		SUBSET: GENERAL			
		STR. NO'S.	N/A		
		SHEETS:	GRD-01 OF 02		
					SHEET NUMBER 03

MATCH LINE A-A

MAY 2024 - FINAL PLANS - NOT FOR CONSTRUCTION

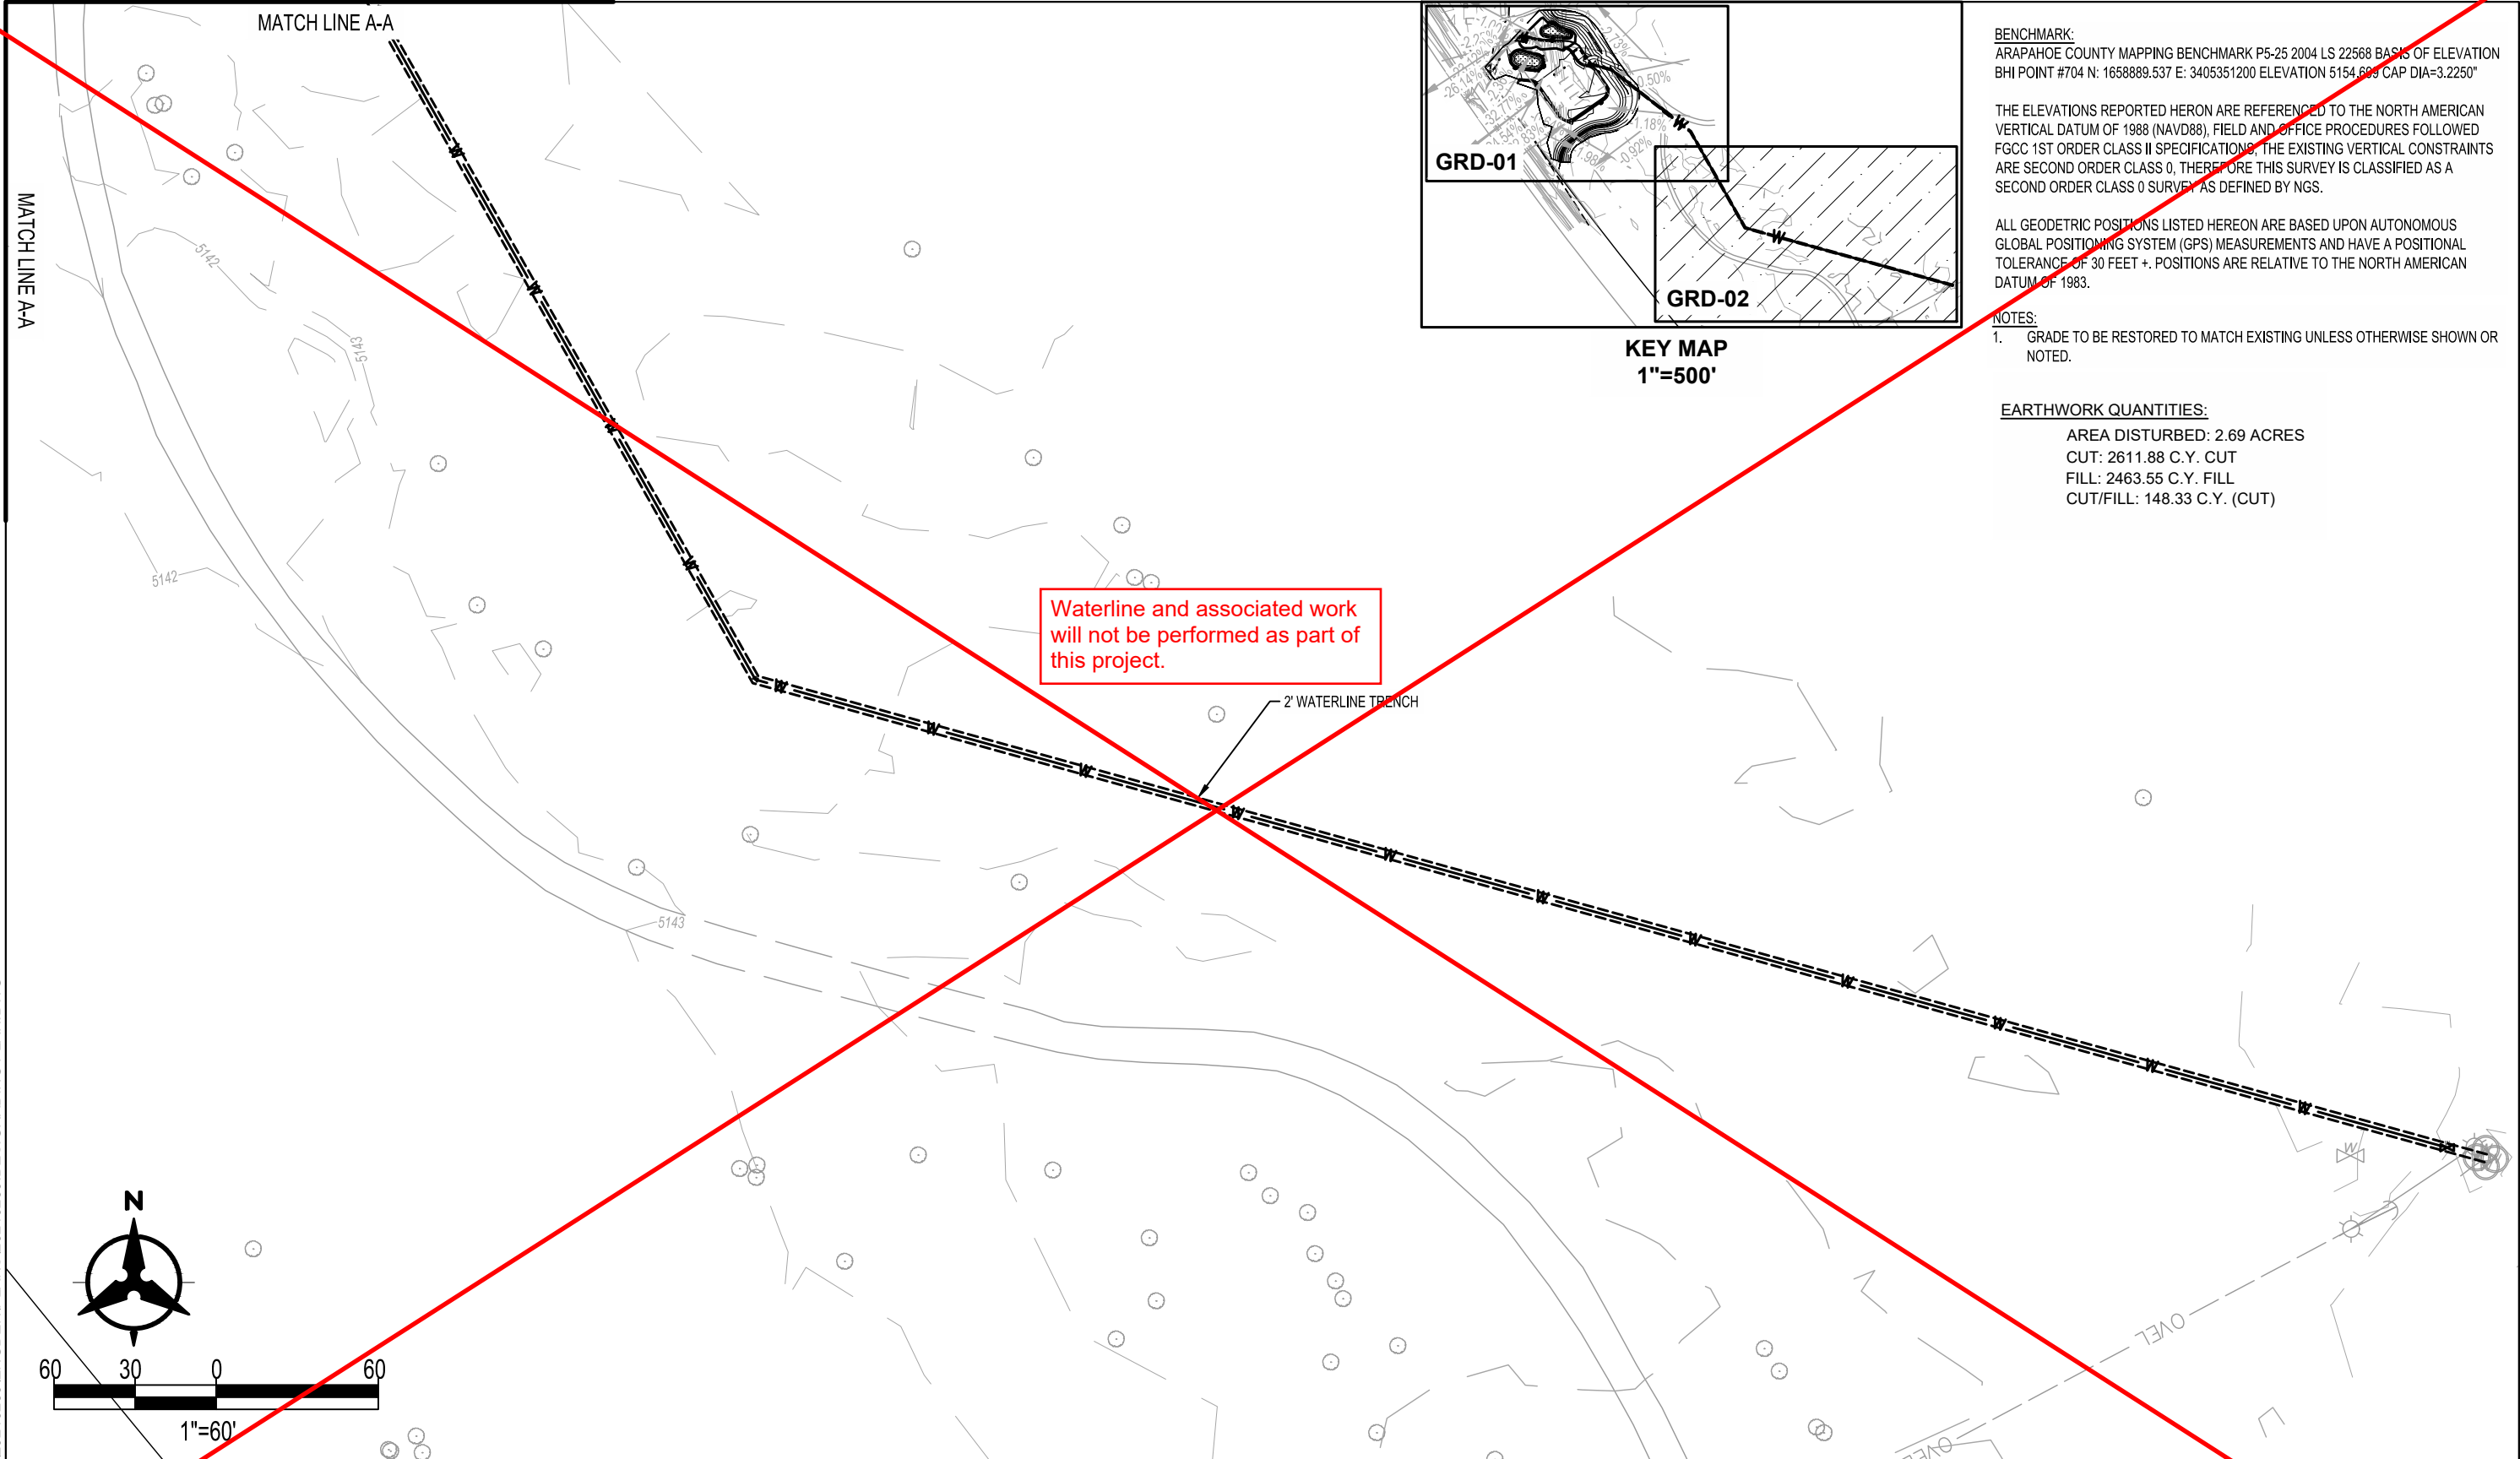

BENCHMARK:
ARAPAHOE COUNTY MAPPING BENCHMARK P5-25 2004 LS 22568 BASIS OF ELEVATION
BHI POINT #704 N: 1658889.537 E: 3405351200 ELEVATION 5154.669 CAP DIA=3.2250"

THE ELEVATIONS REPORTED HEREON ARE REFERENCED TO THE NORTH AMERICAN
VERTICAL DATUM OF 1988 (NAVD88). FIELD AND OFFICE PROCEDURES FOLLOWED
FGCC 1ST ORDER CLASS II SPECIFICATIONS. THE EXISTING VERTICAL CONSTRAINTS
ARE SECOND ORDER CLASS 0, THEREFORE THIS SURVEY IS CLASSIFIED AS A
SECOND ORDER CLASS 0 SURVEY AS DEFINED BY NGS.


ALL GEODETRIC POSITIONS LISTED HEREON ARE BASED UPON AUTONOMOUS
GLOBAL POSITIONING SYSTEM (GPS) MEASUREMENTS AND HAVE A POSITIONAL
TOLERANCE OF 30 FEET +. POSITIONS ARE RELATIVE TO THE NORTH AMERICAN
DATUM OF 1983.

NOTES:
1. GRADE TO BE RESTORED TO MATCH EXISTING UNLESS OTHERWISE SHOWN OR
NOTED.

EARTHWORK QUANTITIES:
AREA DISTURBED: 2.69 ACRES
CUT: 2611.88 C.Y. CUT
FILL: 2463.55 C.Y. FILL
CUT/FILL: 148.33 C.Y. (CUT)

Waterline and associated work
will not be performed as part of
this project.

2' WATERLINE TRENCH

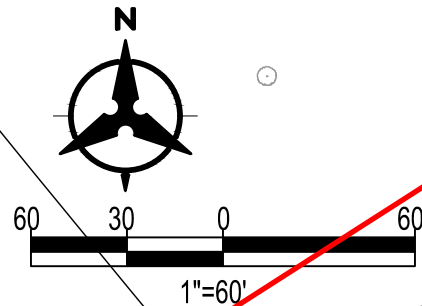

\\A-CO-FS\PROJECTS\20240239\ENG\EN\PLANS\20240239.DES\GRADING PLAN.DWG

PLOTTED BY: JESSICA MCELWAIN, 5/9/2024 12:59 PM

HORIZ. SCALE: VERT. SCALE:

Bohannon

Huston

www.bhinc.com

800.877.5332

9785 Maroon Circle Suite 140 Englewood , CO 80112-5928


R-X	SHEET REVISIONS		
	DATE	DESIGNER:	INITIALS






ARAPAHOE COUNTY

AS CONSTRUCTED		ARAPAHOE COUNTY RICHMIL RANCH OPEN SPACE GRADING PLAN			PROJECT NO./CODE
NO REVISIONS:		DESIGNER: ATC			
REVISED:		DETAILER: DCP			
VOID:		SUBSET: GENERAL			
		STR. NO'S.	N/A		
		SHEETS:	GRD-02 OF 02		
					SHEET NUMBER 04

MAY 2024 - FINAL PLANS - NOT FOR CONSTRUCTION

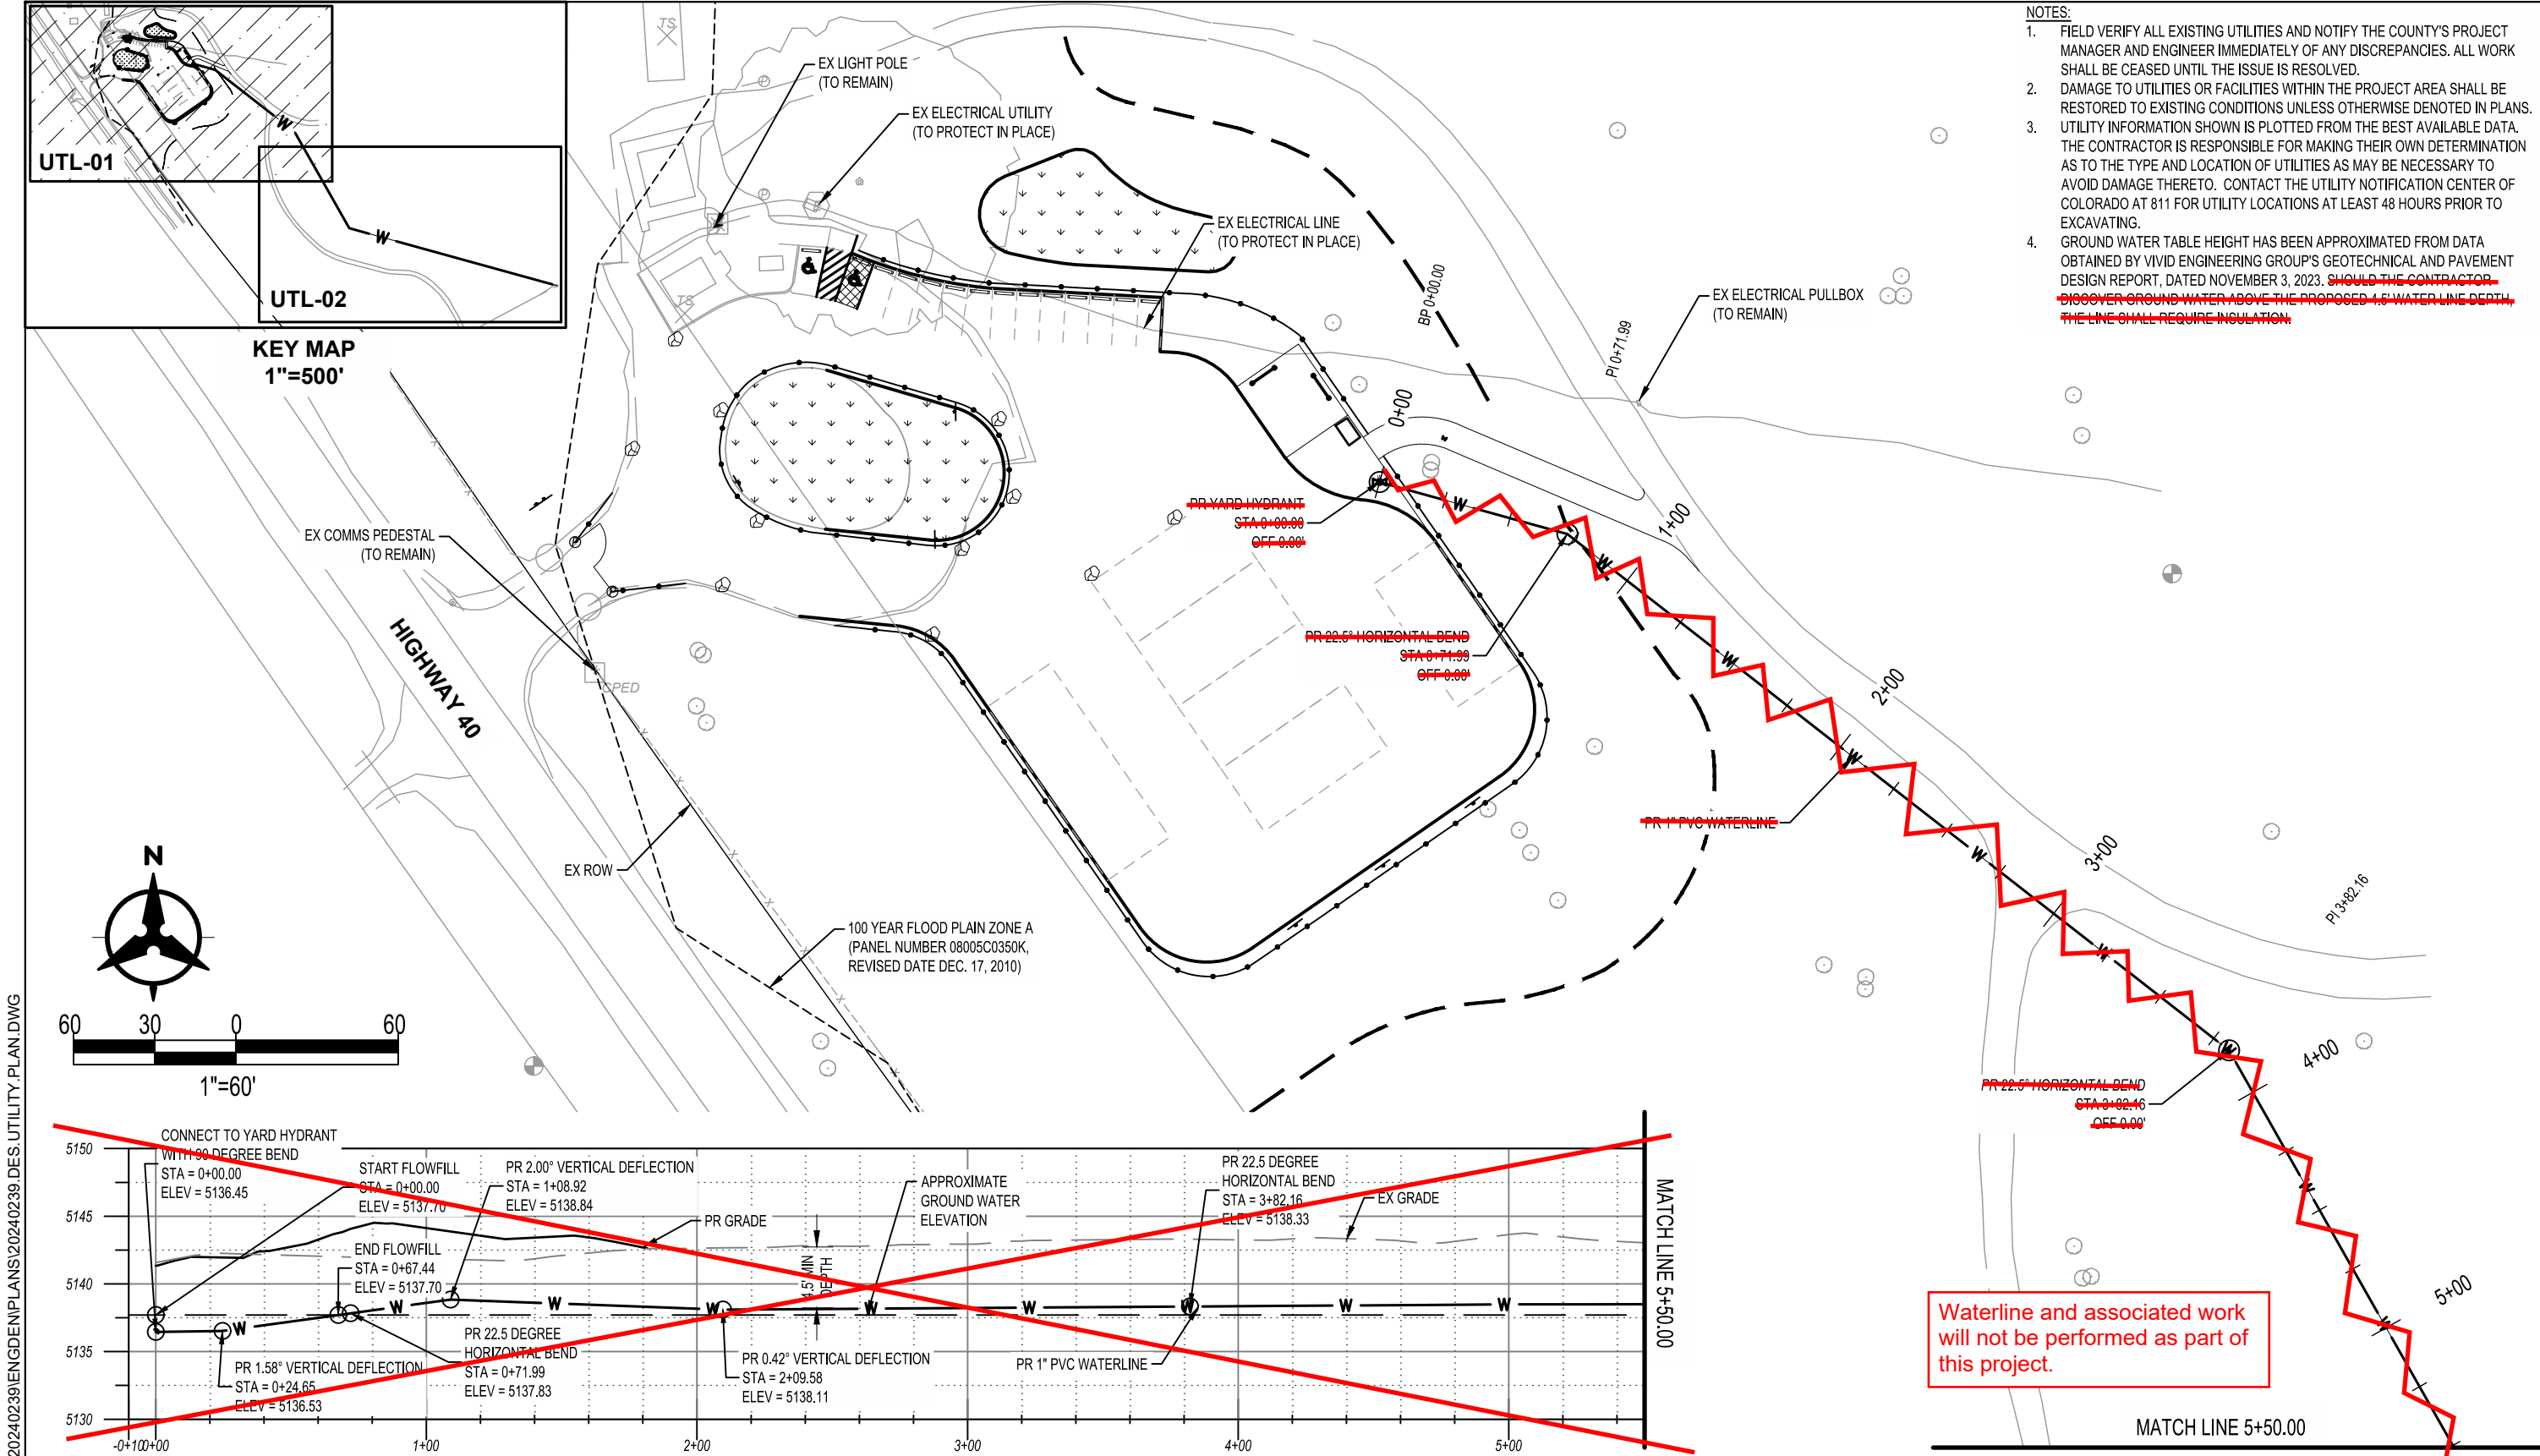

- NOTES:
1. FIELD VERIFY ALL EXISTING UTILITIES AND NOTIFY THE COUNTY'S PROJECT MANAGER AND ENGINEER IMMEDIATELY OF ANY DISCREPANCIES. ALL WORK SHALL BE CEASED UNTIL THE ISSUE IS RESOLVED.
 2. DAMAGE TO UTILITIES OR FACILITIES WITHIN THE PROJECT AREA SHALL BE RESTORED TO EXISTING CONDITIONS UNLESS OTHERWISE DENOTED IN PLANS.
 3. UTILITY INFORMATION SHOWN IS PLOTTED FROM THE BEST AVAILABLE DATA. THE CONTRACTOR IS RESPONSIBLE FOR MAKING THEIR OWN DETERMINATION AS TO THE TYPE AND LOCATION OF UTILITIES AS MAY BE NECESSARY TO AVOID DAMAGE THERETO. CONTACT THE UTILITY NOTIFICATION CENTER OF COLORADO AT 811 FOR UTILITY LOCATIONS AT LEAST 48 HOURS PRIOR TO EXCAVATING.
 4. GROUND WATER TABLE HEIGHT HAS BEEN APPROXIMATED FROM DATA OBTAINED BY VIVID ENGINEERING GROUP'S GEOTECHNICAL AND PAVEMENT DESIGN REPORT, DATED NOVEMBER 3, 2023. ~~SHOULD THE CONTRACTOR DISCOVER GROUND WATER ABOVE THE PROPOSED 4.5' WATER LINE DEPTH, THE LINE SHALL REQUIRE INSULATION.~~

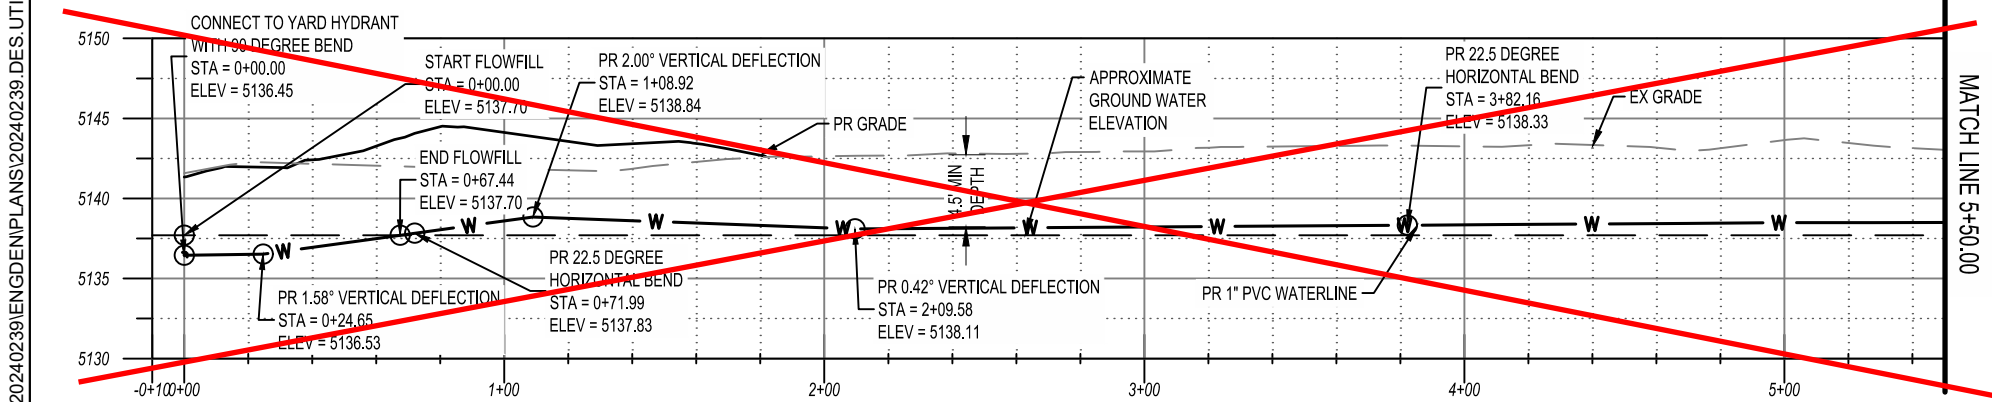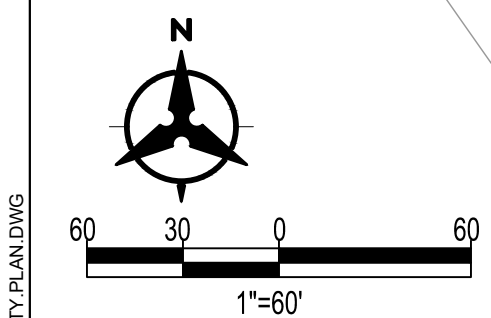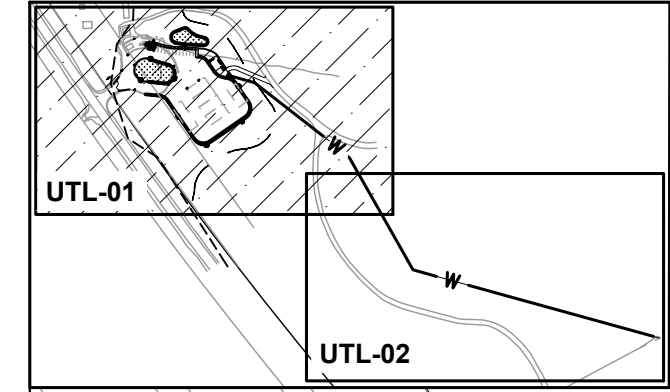


Waterline and associated work will not be performed as part of this project.

PLOTTED BY: JESSICA MCELWAIN, 5/9/2024 12:59 PM		SHEET REVISIONS		AS CONSTRUCTED		ARAPAHOE COUNTY RICHMIL RANCH OPEN SPACE UTILITY PLAN		PROJECT NO./CODE	
HORIZ. SCALE:	VERT. SCALE:								
 www.bhinc.com 7985 Maroon Circle Suite 140 Englewood, CO 80112-5928		R-X	DATE	DESIGNER:	INITIALS	NO REVISIONS:			
						REVISED:		DESIGNER: ATC	STR. NO'S. ###
						VOID:		DETAILER: DCP	###
								SUBSET: GENERAL	SHEETS: UTL-01 OF 02
								SHEET NUMBER 05	





MAY 2024 - FINAL PLANS - NOT FOR CONSTRUCTION

I:\CO-FSI\PROJECTS\2024\239\ENGIN\PLANS\20240239.DES\UTILITY.PLAN.DWG

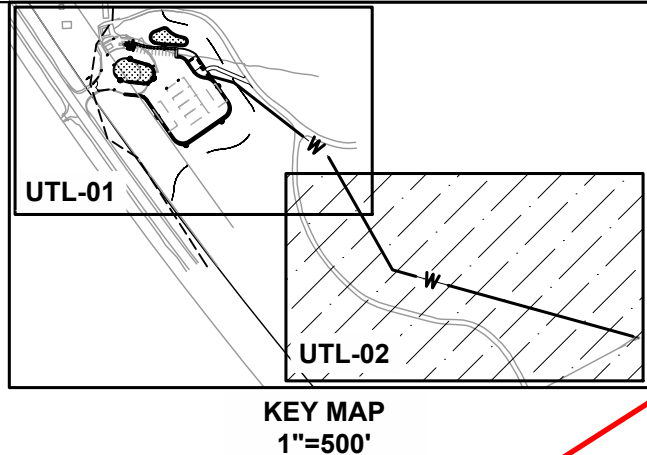

- NOTES:
1. FIELD VERIFY ALL EXISTING UTILITIES AND NOTIFY THE COUNTY'S PROJECT MANAGER AND ENGINEER IMMEDIATELY OF ANY DISCREPANCIES. ALL WORK SHALL BE CEASED UNTIL THE ISSUE IS RESOLVED.
 2. DAMAGE TO UTILITIES OR FACILITIES WITHIN THE PROJECT AREA SHALL BE RESTORED TO EXISTING CONDITIONS UNLESS OTHERWISE DENOTED IN PLANS.
 3. UTILITY INFORMATION SHOWN IS PLOTTED FROM THE BEST AVAILABLE DATA. THE CONTRACTOR IS RESPONSIBLE FOR MAKING THEIR OWN DETERMINATION AS TO THE TYPE AND LOCATION OF UTILITIES AS MAY BE NECESSARY TO AVOID DAMAGE THERETO. CONTACT THE UTILITY NOTIFICATION CENTER OF COLORADO AT 811 FOR UTILITY LOCATIONS AT LEAST 48 HOURS PRIOR TO EXCAVATING.
 4. GROUND WATER TABLE HEIGHT HAS BEEN APPROXIMATED FROM DATA OBTAINED BY VIVID ENGINEERING GROUP'S GEOTECHNICAL AND PAVEMENT DESIGN REPORT, DATED NOVEMBER 3, 2023. SHOULD THE CONTRACTOR DISCOVER GROUND WATER ABOVE THE PROPOSED 4.5' WATER LINE DEPTH, THE LINE SHALL REQUIRE INSULATION.

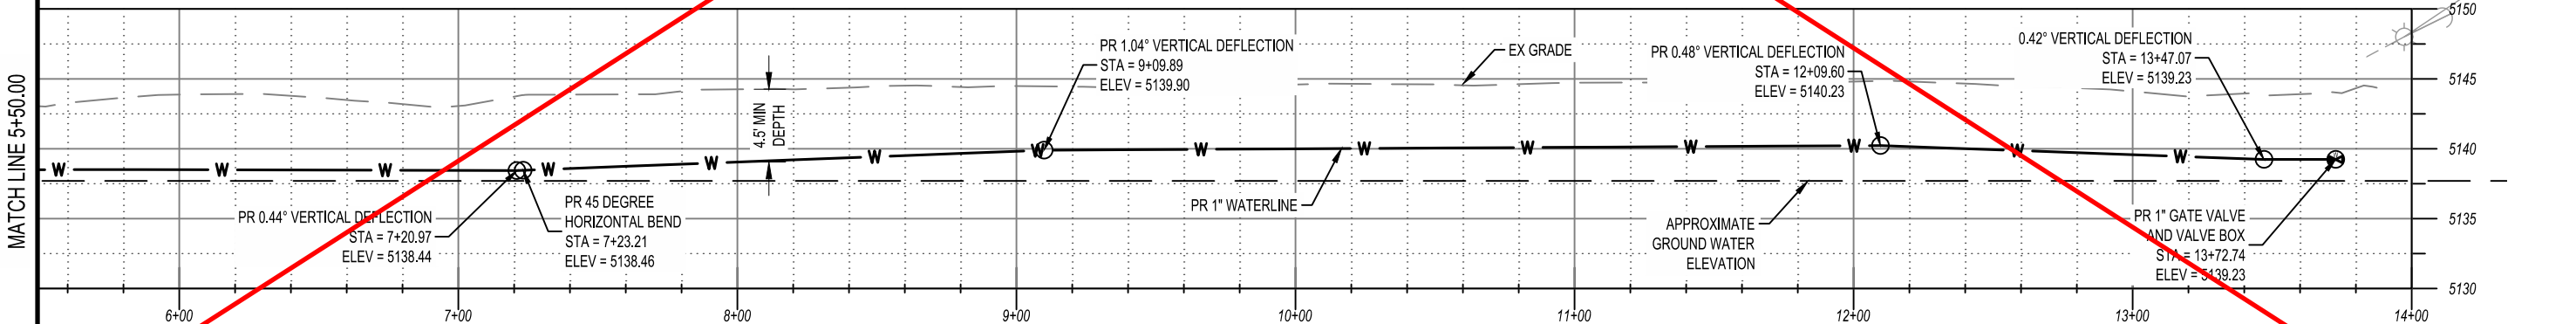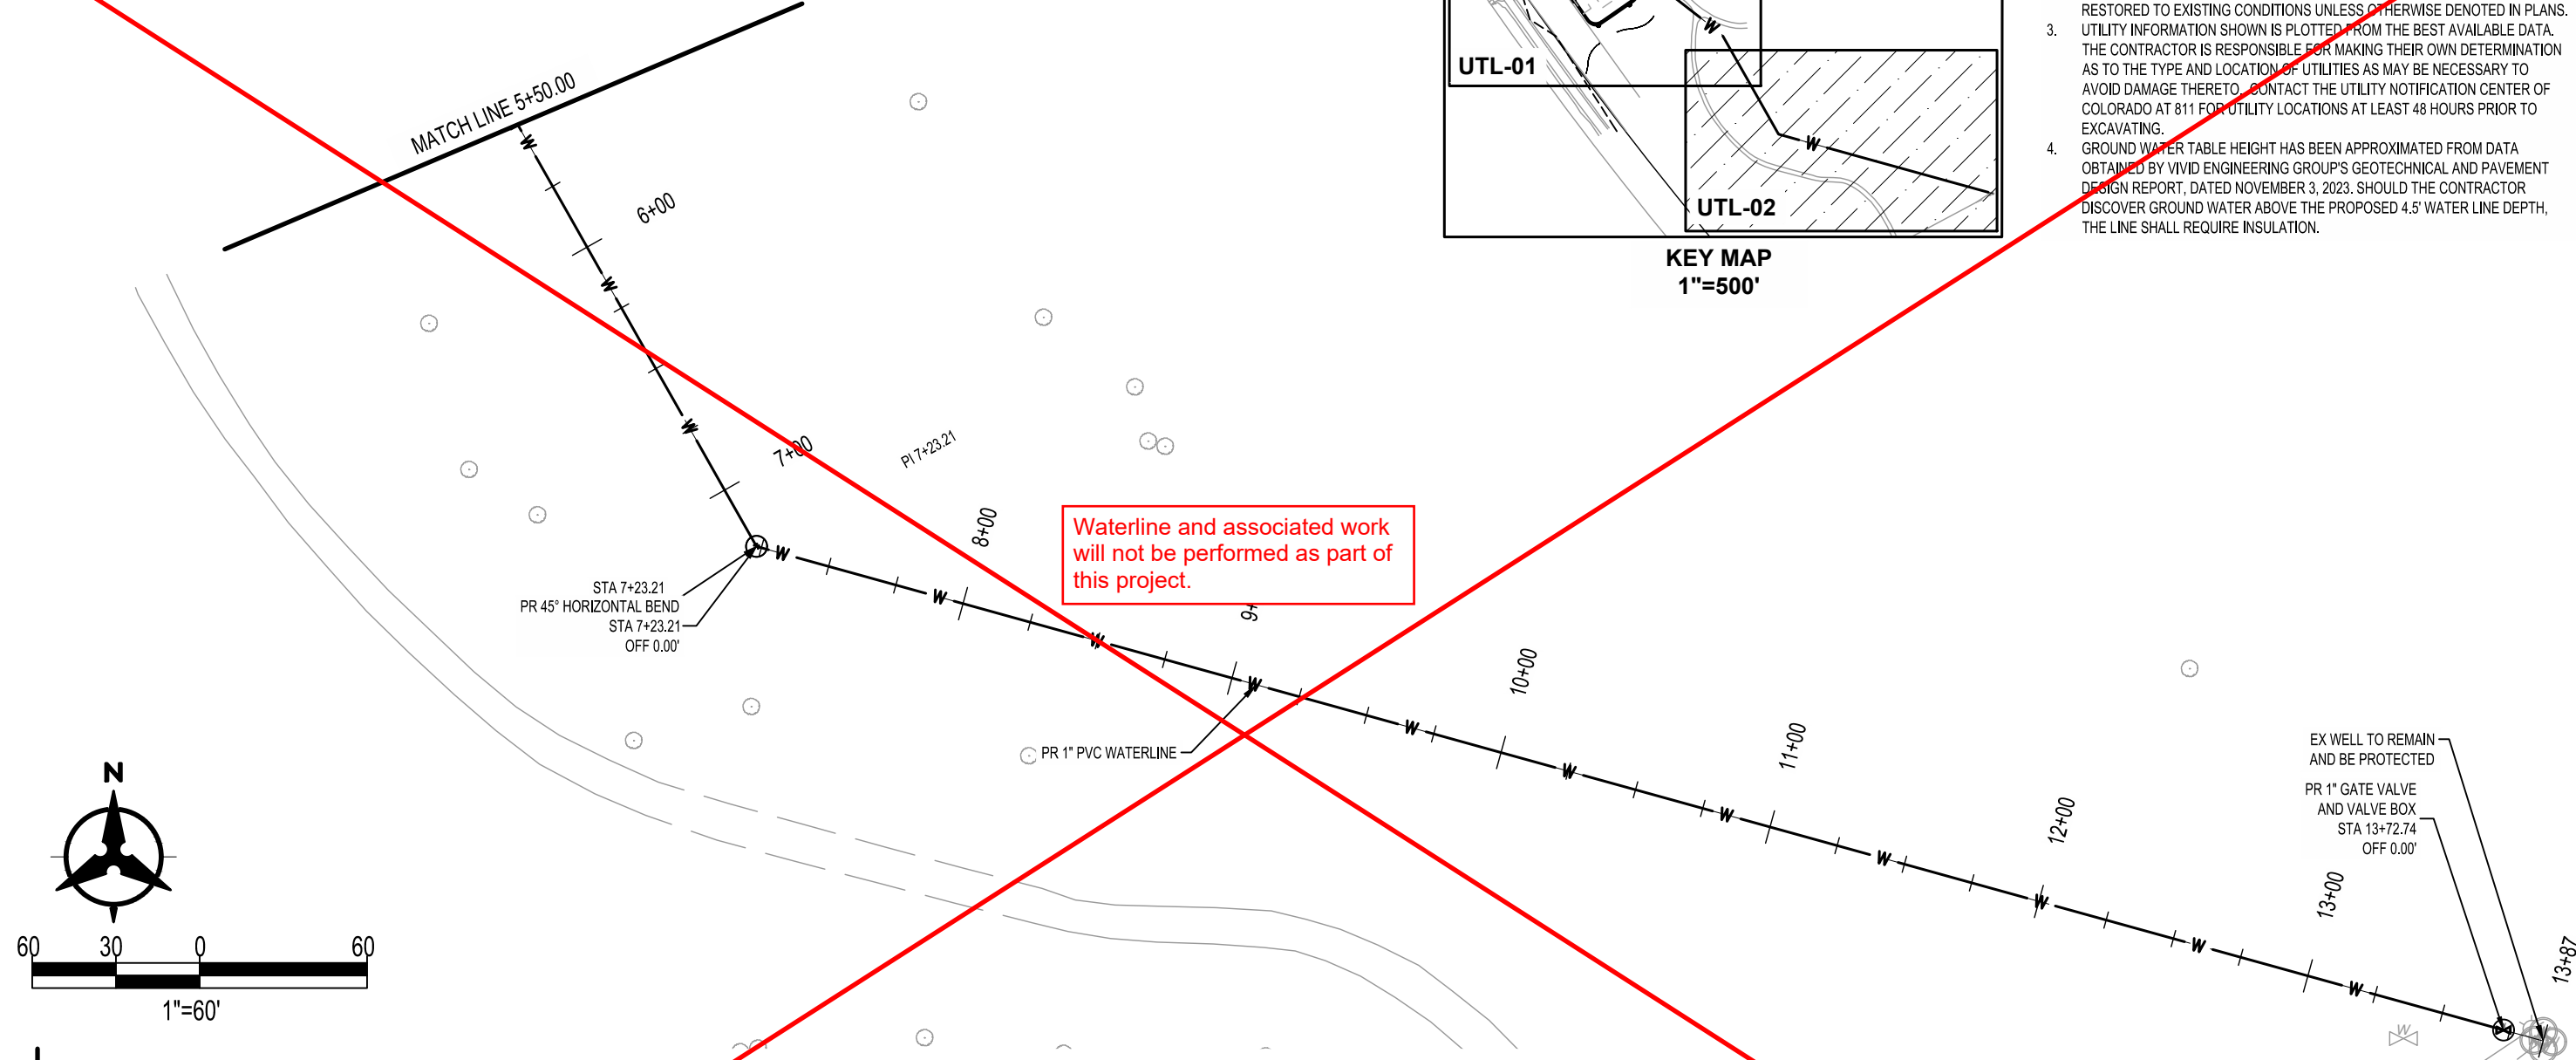

PLOTTED BY: JESSICA MCELWAIN, 5/9/2024 12:59 PM
HORIZ. SCALE: VERT. SCALE:


Behannan & Huston
www.bhinc.com 800.877.5332
9785 Maroon Circle Suite 140 Englewood, CO 80112-5928

SHEET REVISIONS			
R-X	DATE	DESIGNER:	INITIALS




AS CONSTRUCTED		ARAPAHOE COUNTY RICHMIL RANCH OPEN SPACE UTILITY PLAN			PROJECT NO./CODE
NO REVISIONS:					
REVISED:		DESIGNER: ATC	STR. NO'S.	N/A	
VOID:		DETAILER: DCP		N/A	
		SUBSET: GENERAL	SHEETS:	UTL-02 OF 02	SHEET NUMBER 06

MAY 2024 - FINAL PLANS - NOT FOR CONSTRUCTION

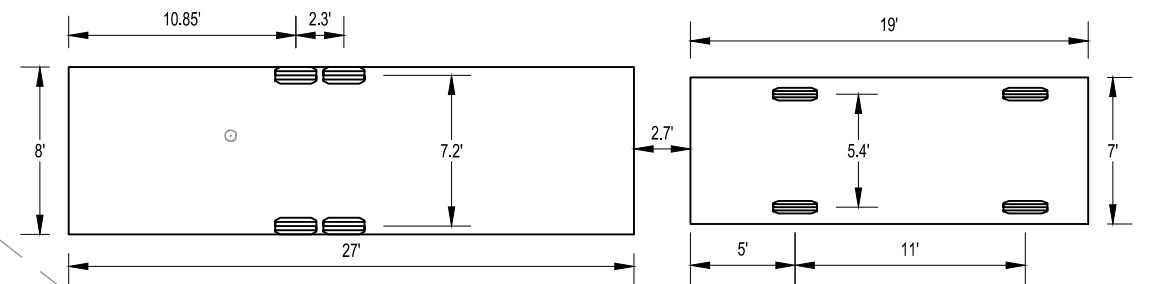



AASHTO 2011 STANDARD P/T CAR AND TRAILER DESIGN VEHICLE

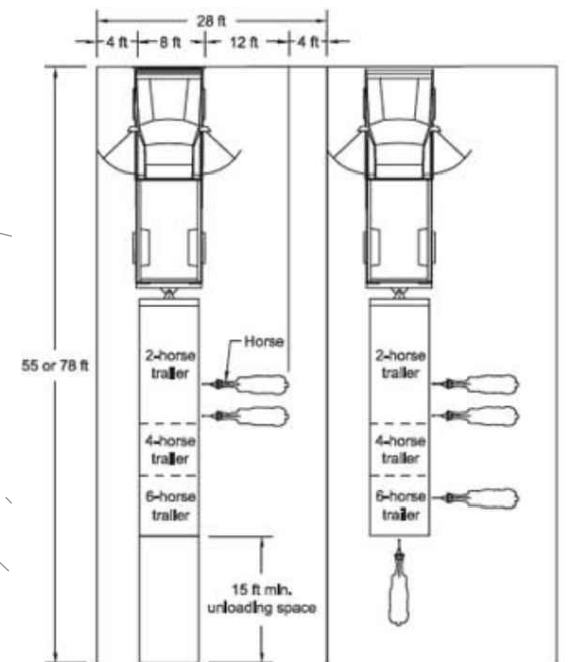

HORSE TRAILER PARKING DIAGRAMS

NOTES:

1. PARKING LOT SURFACE TO BE CONSTRUCTED WITH CLASS 6 AGGREGATE BASE COURSE. ADA SPACES WILL BE CONSTRUCTED WITH 6" CONCRETE PAVEMENT. FOR MORE INFORMATION ON PAVEMENT SECTIONS, REFER TO DETAIL SHEET DET-01.

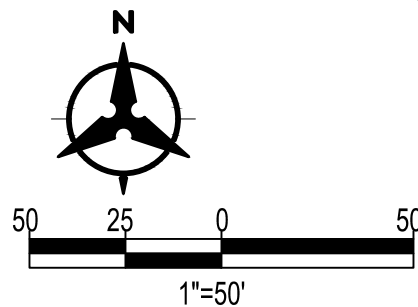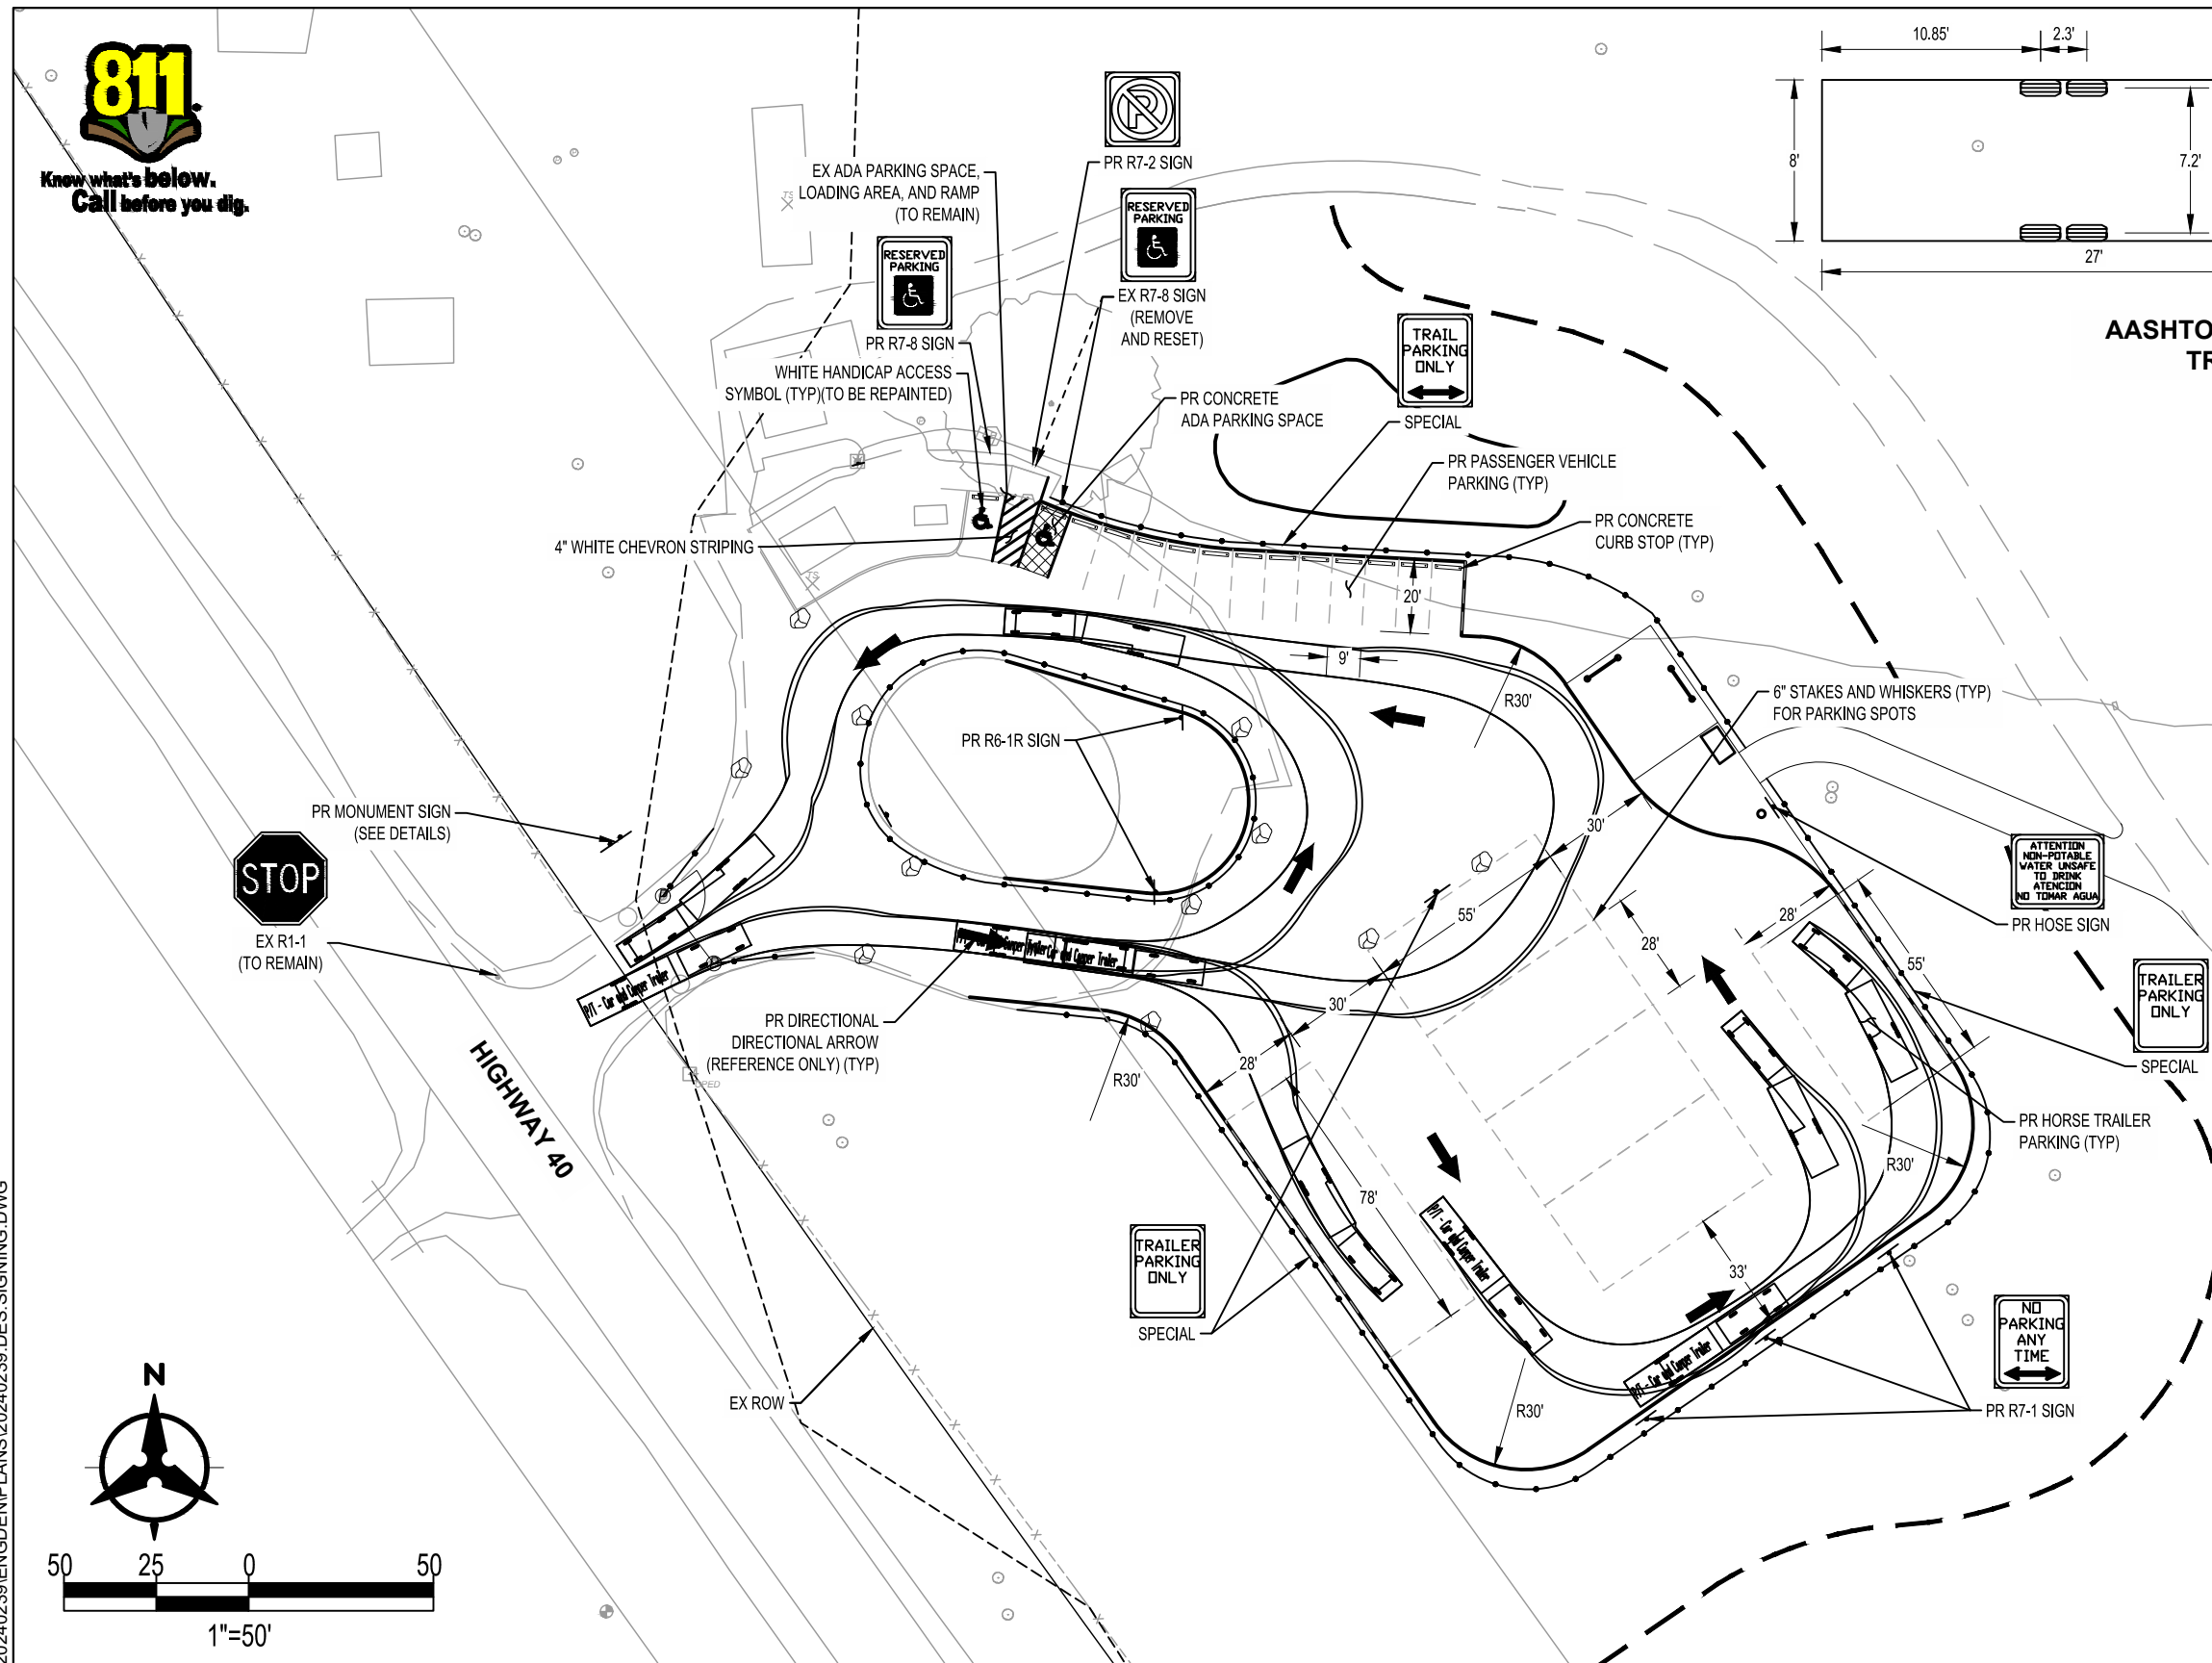

PLOTTED BY: JESSICA MCELWAIN, 5/9/2024 12:59 PM

HORIZ. SCALE:	VERT. SCALE:
---------------	--------------

Bohannon  **Huston**

www.bhinc.com 800.877.5332
785 Maroon Circle Suite 140 Englewood, CO 80112-5928

R-X

SHEET REVISIONS

DATE	DESIGNER:	INITIALS

**ARAPAHOE COUNTY**

AS CONSTRUCTED

NO REVISIONS:

REVISÉ:

VOID:

**ARAPAHOE COUNTY
RICHMIL RANCH OPEN SPACE
STRIPING AND CIRCULATION PLAN**

DESIGNER: ATC

DETAILER: DCP

SUBSET: GENERAL

STR

NO'S.	
-------	--

SHEETS: STR-01 OF 01

N/A

N/A



STR-01 OF 01

PROJECT NO./CODE


SHEET NUMBER

MAY 2024 - FINAL PLANS - NOT FOR CONSTRUCTION


LA-CO-FS\PROJECTS\20240239\ENGDEN\PLANS\20240239.DES.SIGNING.DWG

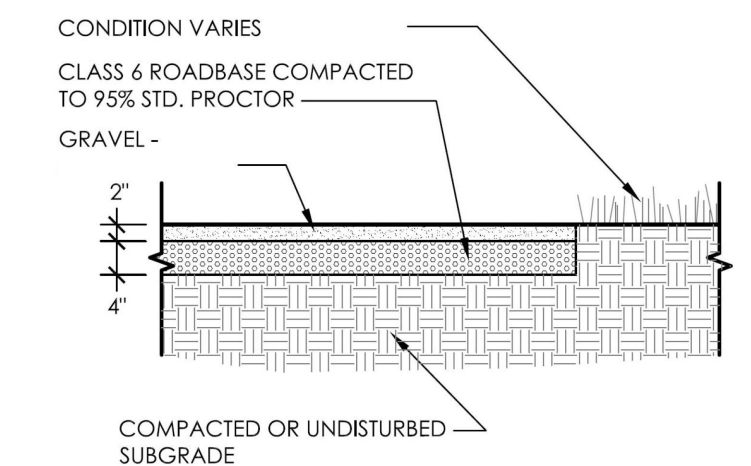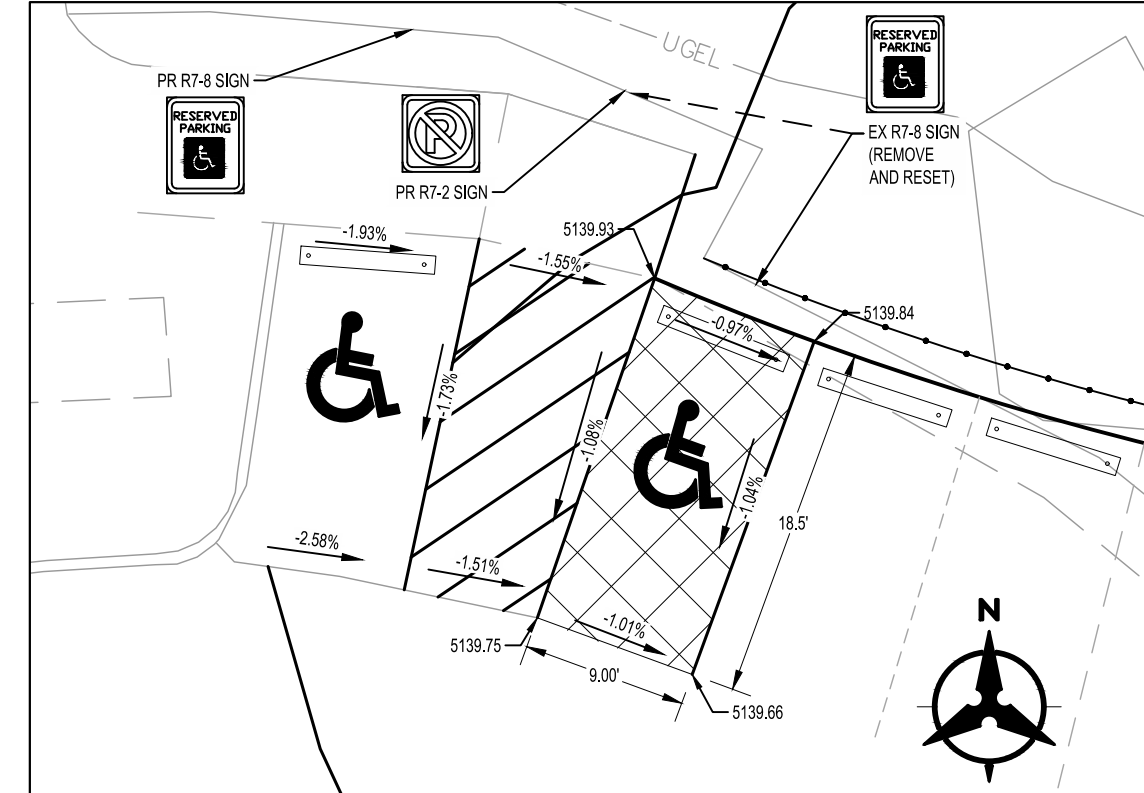


AGGREGATE BASE COURSE SECTION
NOT TO SCALE

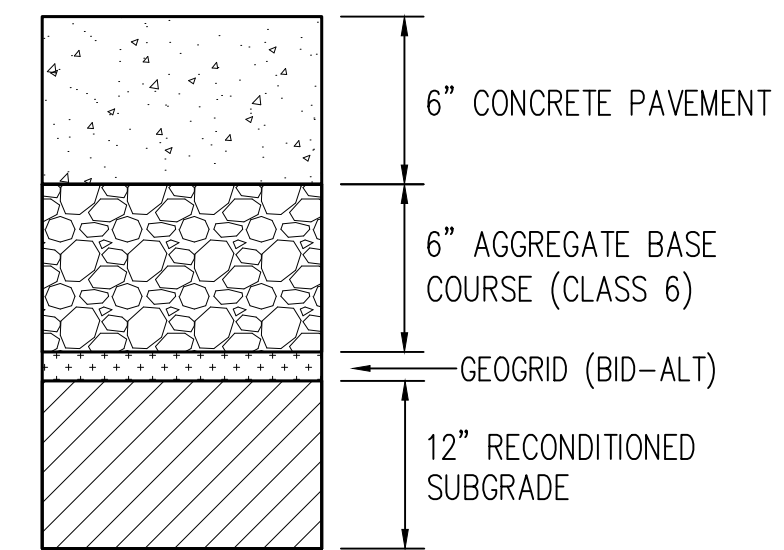

CONCRETE PAVEMENT SECTION
NOT TO SCALE

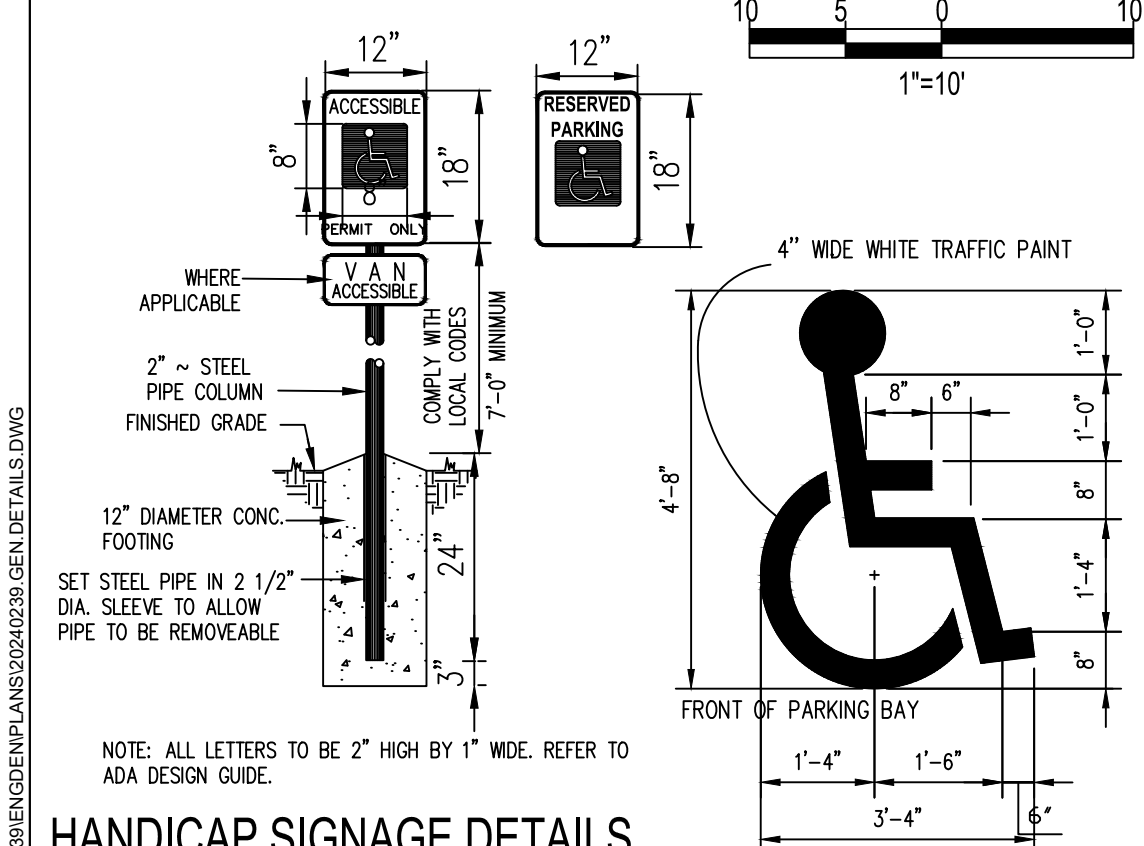


HANDICAP SIGNAGE DETAILS
NOT TO SCALE

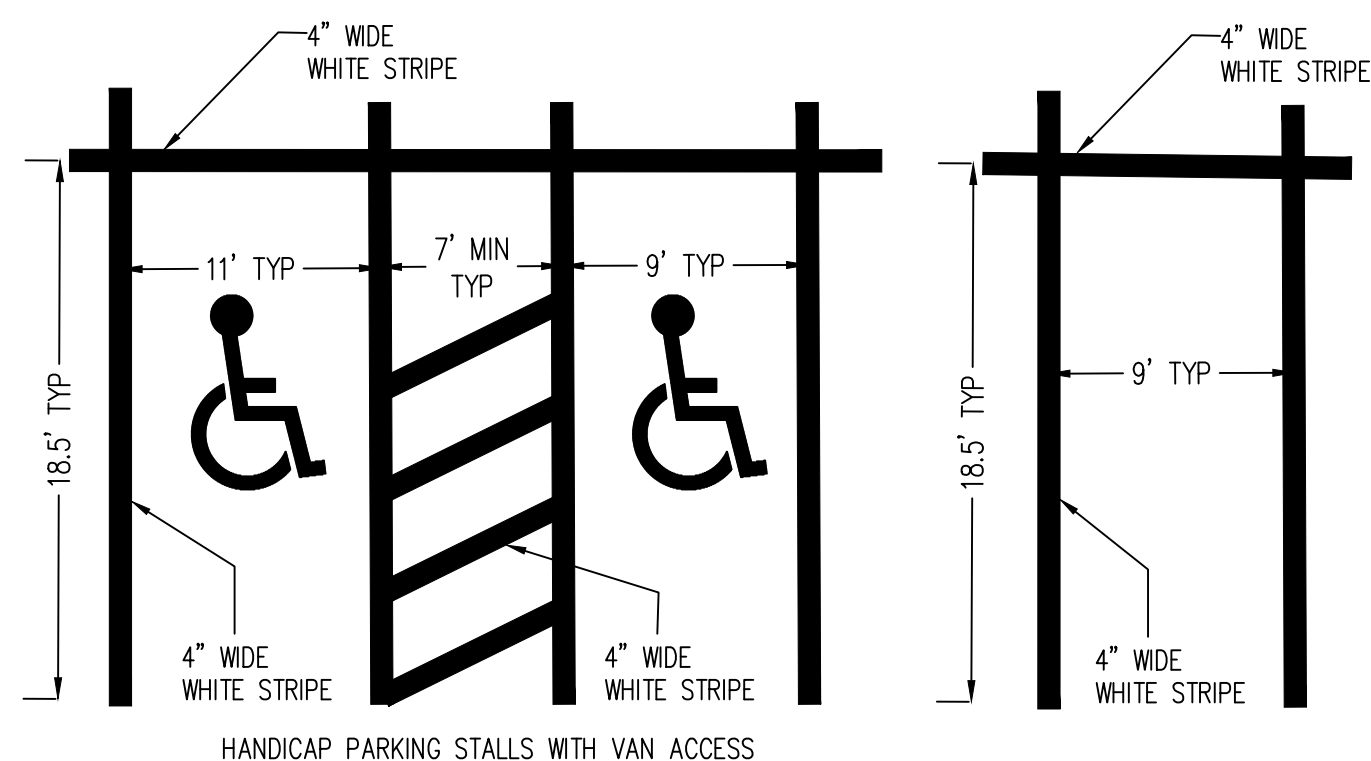

STRIPING DETAILS
NOT TO SCALE


<

MAY 2024 - FINAL PLANS - NOT FOR CONSTRUCTION

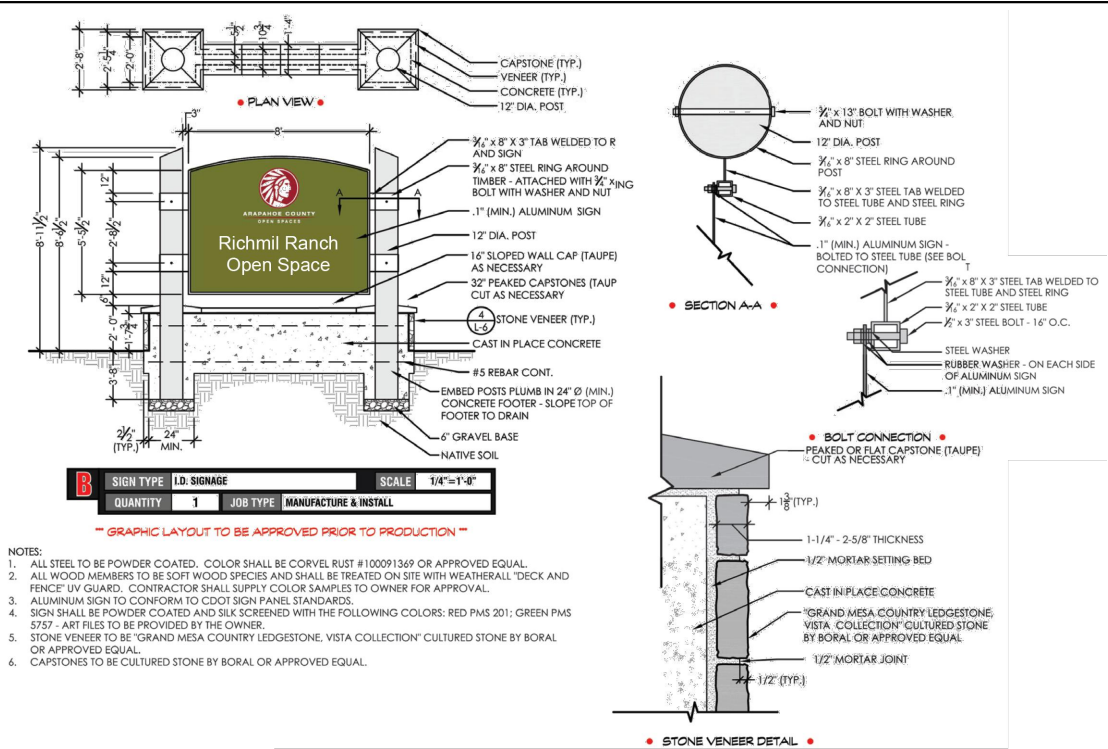


MONUMENT SIGN

NOT TO SCALE

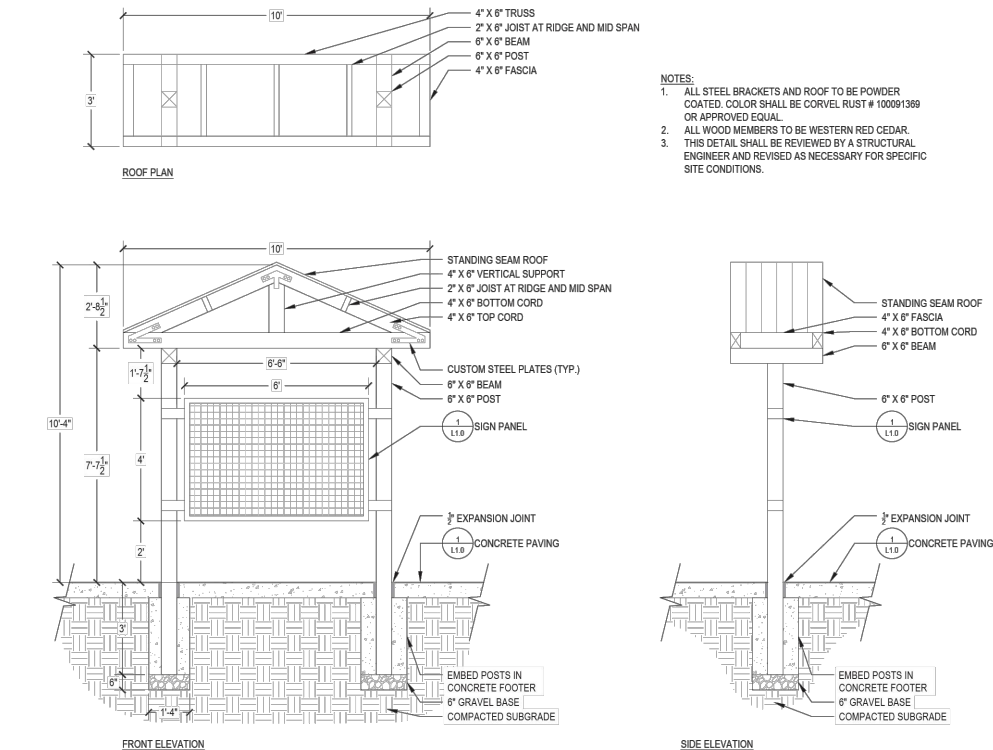


KIOSK SIGN

NOT TO SCALE

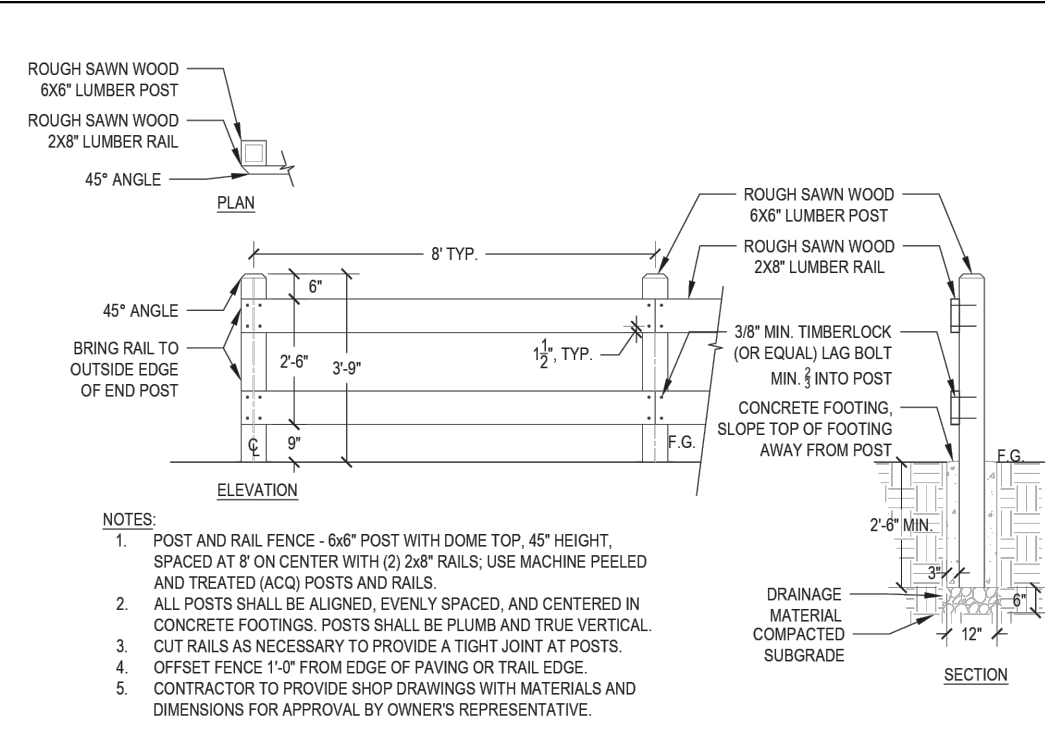

WOODEN POST & RAIL FENCE

NOT TO SCALE

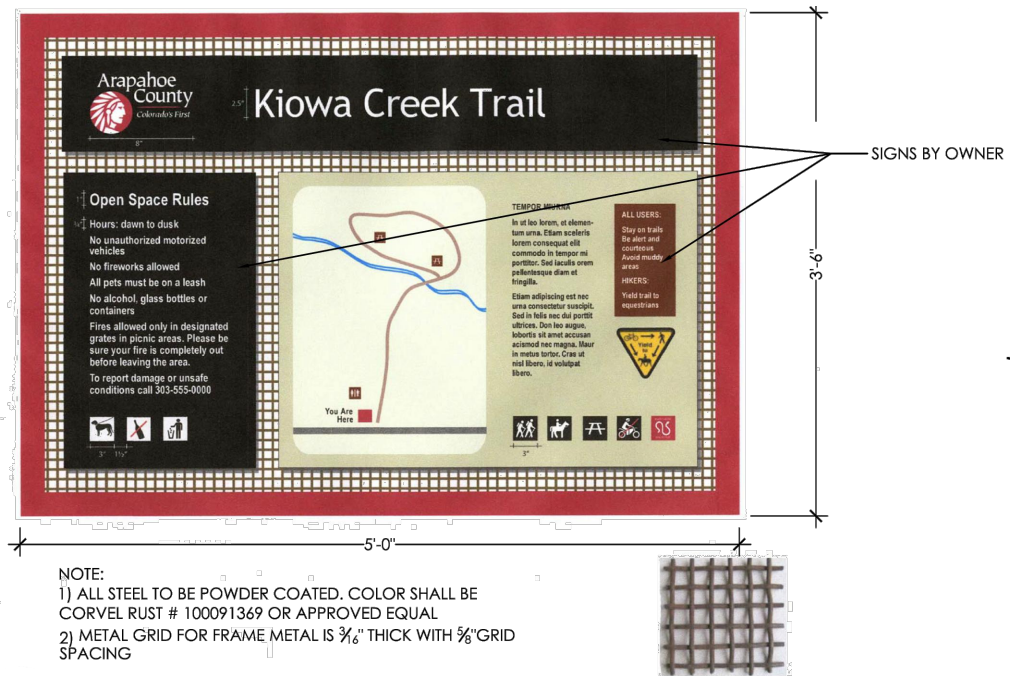


KIOSK SIGN PANEL

NOT TO SCALE


IA-CO-FSI\PROJECTS\20240239\ENGINEERING\PLANS\20240239_GEN.DETAILS.DWG

PLOTTED BY: JESSICA MCELWAIN, 5/9/2024 1:00 PM		SHEET REVISIONS			AS CONSTRUCTED		ARAPAHOE COUNTY RICHMIL RANCH OPEN SPACE DETAILS			PROJECT NO./CODE	
HORIZ. SCALE:											
<div>Bohannon & Huston</div> <div>www.bhinc.com 800.877.5332</div> <div>9785 Maroon Circle Suite 140 Englewood , CO 80112-5928</div>		(R-X)	DATE	DESIGNER:	INITIALS	NO REVISIONS:		DESIGNER: ATC		N/A	
						REVISED:		DETAILER: DCP		N/A	
						VOID:		SUBSET: GENERAL		SHEETS: DET-02 OF 04	
					<div>ARAPAHOE COUNTY</div>						


MAY 2024 - FINAL PLANS - NOT FOR CONSTRUCTION

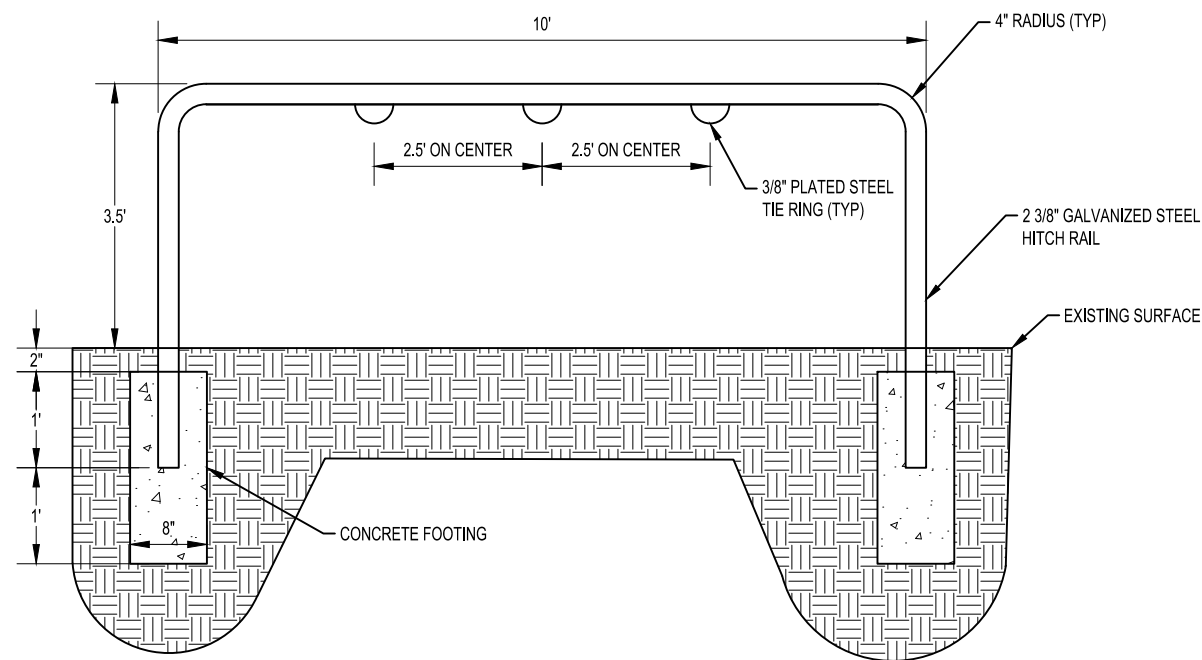


NOT TO SCALE

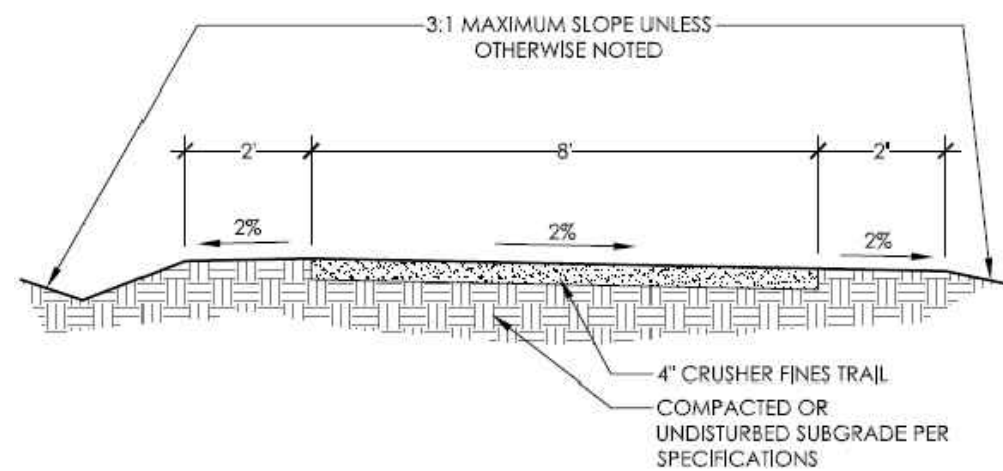

NOT TO SCALE

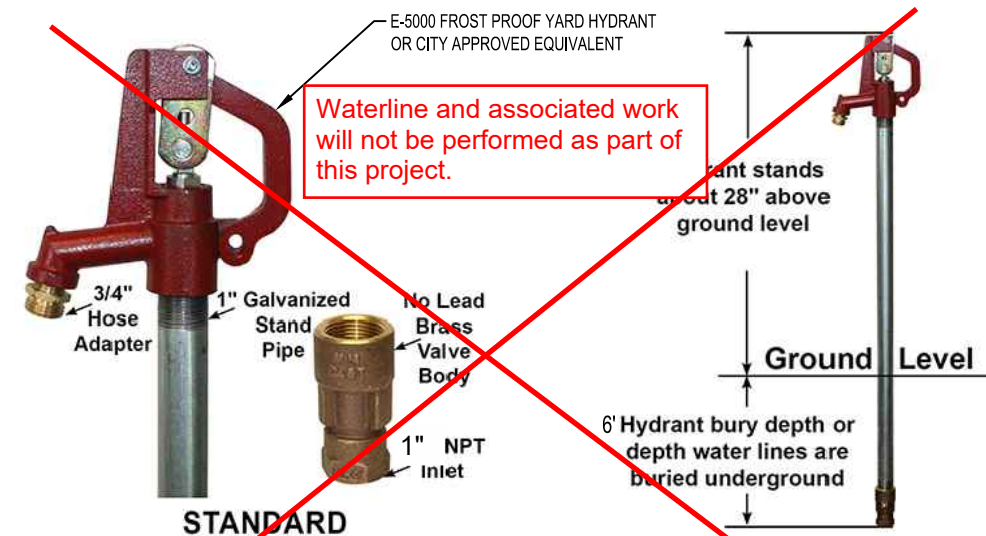

NOT TO SCALE

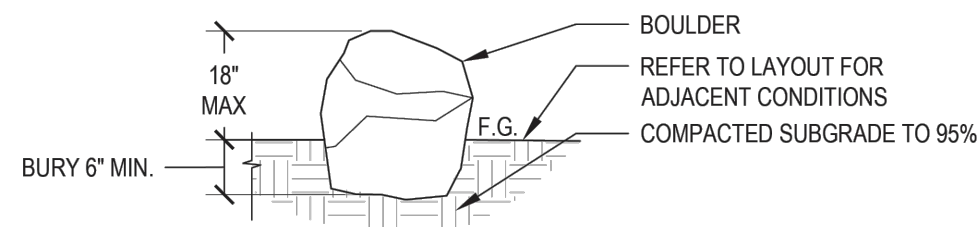


NOTES:

1. PLACE BOULDERS TO CONFIGURATIONS AND LOCATION AS SHOWN ON PLAN.
2. SELECT AND PLACE BOULDER SO THAT A MINIMUM OF EXCAVATION SCARS ARE VISIBLE.
3. BOULDERS TO BE APPROVED BY PROJECT MANAGER PRIOR TO PLACEMENT.
4. DO NOT FRACTURE BOULDER DURING PLACEMENT, SUCH ACTION WILL BE CAUSE FOR REJECTION.
5. WASH OFF BOULDERS COMPLETELY AFTER PLACEMENT.
6. UNLESS OTHERWISE CALLED OUT ON PLANS OR OTHER DETAILS, LANDSCAPE BOULDERS ARE ASSUMED TO BE A MINIMUM OF 1.5 CUBIC FEET.

LANDSCAPE BOULDER


NOT TO SCALE

I:\A-FO-FSI\PROJECTS\2024\0239\ENGINEERING\PLANS\20240239_GEN DETAILS.DWG

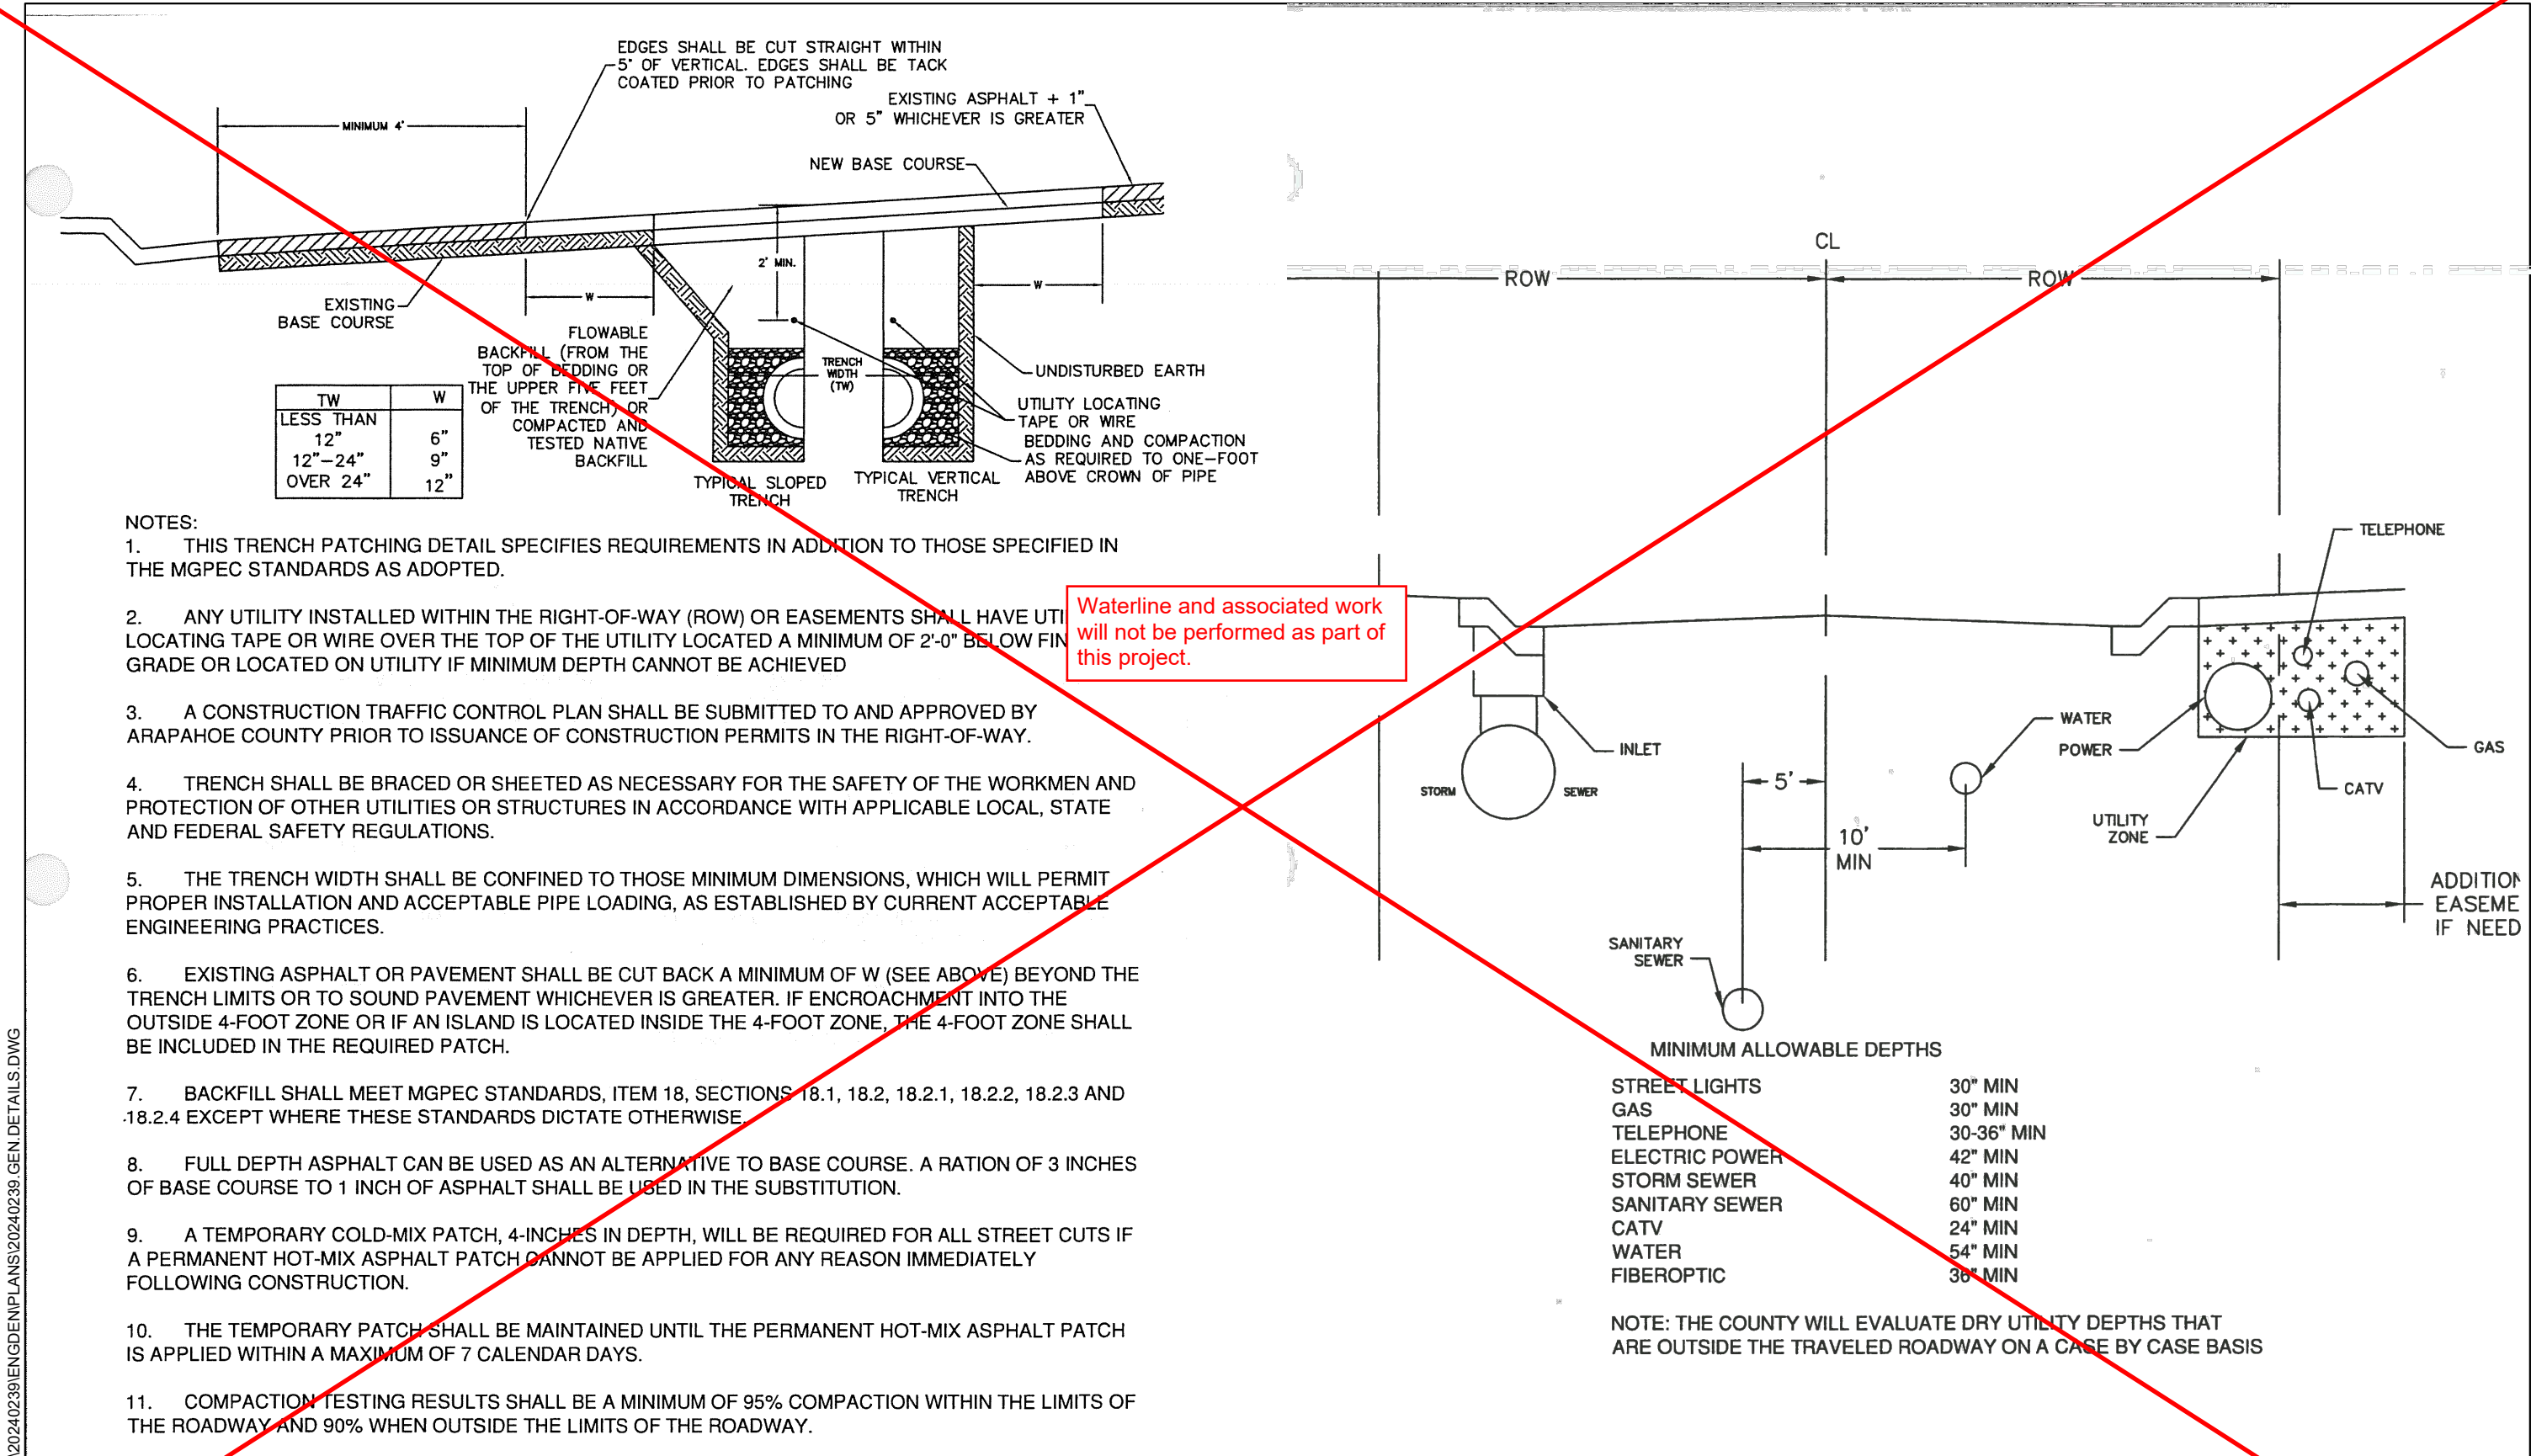

MAY 2024 - FINAL PLANS - NOT FOR CONSTRUCTION

PLOTTED BY: JESSICA MCELWAIN, 5/9/2024 1:00 PM HORIZ. SCALE: VERT. SCALE:	SHEET REVISIONS			 ARAPAHOE COUNTY	AS CONSTRUCTED		ARAPAHOE COUNTY RICHMIL RANCH OPEN SPACE DETAILS			PROJECT NO./CODE		
					NO REVISIONS:							
					REVISED:		DESIGNER: ATC		STR. NO'S.	N/A		
					VOID:		DETAILER: DCP			N/A		
							SUBSET: GENERAL		SHEETS: DET-04 OF 04		SHEET NUMBER 11	
<div>Bohannon & Huston</div> <div>www.bhinc.com 800.877.5332</div> <div>9785 Maroon Circle Suite 140 Englewood, CO 80112-5928</div>		<div>(R-X)</div> <div></div> <div></div> <div></div> <div></div>	<div>DATE</div> <div></div> <div></div> <div></div> <div></div>	<div>DESIGNER:</div> <div></div> <div></div> <div></div> <div></div>	<div>INITIALS</div> <div></div> <div></div> <div></div> <div></div>							

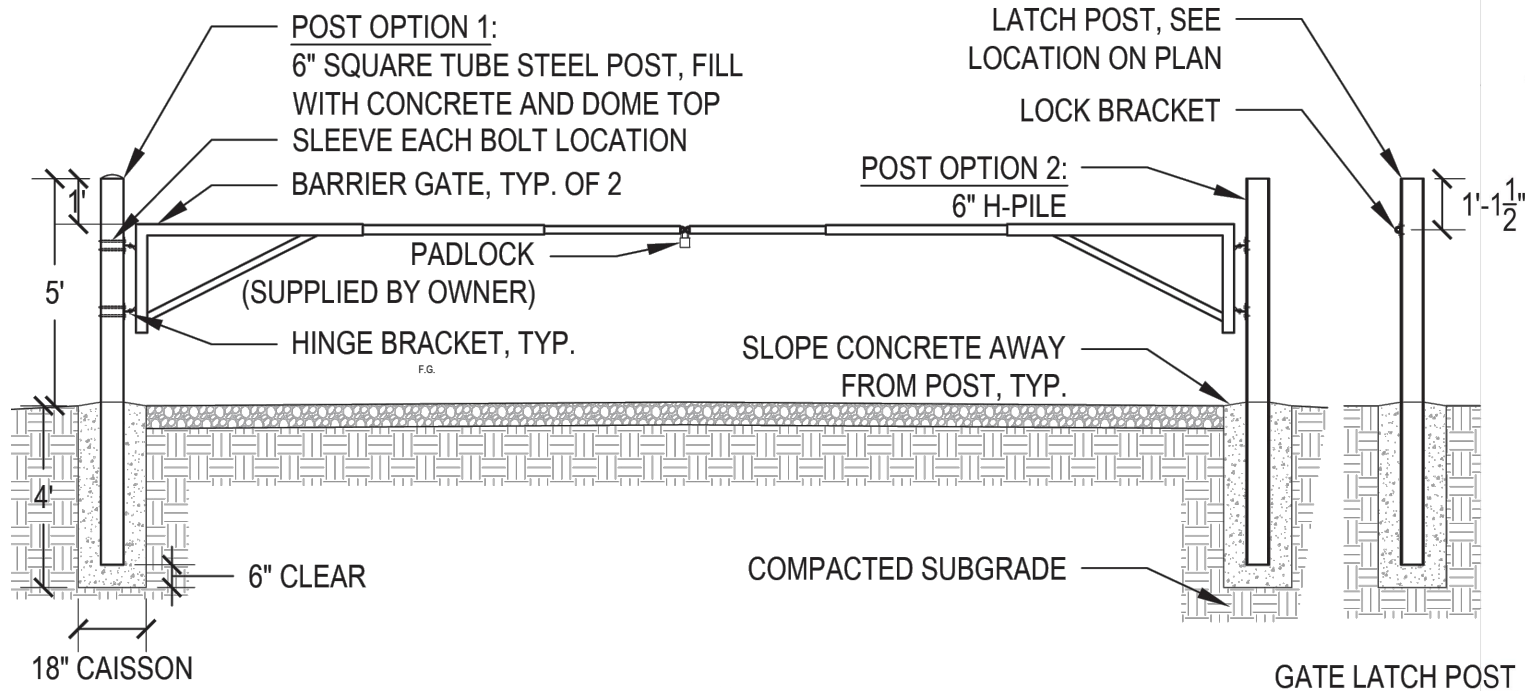

ENTRY GATE

NOT TO SCALE

\\A-CO-FS\PROJECTS\20240239\ENGINE\PLANS\20240239_GEN.DETAILS.DWG

PLOTTED BY: JESSICA MCELWAIN, 5/9/2024 1:00 PM		SHEET REVISIONS			AS CONSTRUCTED		ARAPAHOE COUNTY RICHMIL RANCH OPEN SPACE PROJECT NAME 1			PROJECT NO./CODE	
HORIZ. SCALE:	VERT. SCALE:										
 www.bhinc.com 800.877.5332 9785 Maroon Circle Suite 140 Englewood, CO 80112-5928		(R-X)	DATE	DESIGNER:	INITIALS	NO REVISIONS:					
						REVISED:		DESIGNER: ####	STR. NO'S.	N/A	
						VOID:		DETAILER: ####		N/A	
								SUBSET: GENERAL	SHEETS: DET-05 OF 01	SHEET NUMBER 12	

